

[illegible]



DRAWING TITLE: NBN Co. PIT & PIPE INFRASTRUCTURE TO PROPOSED SUBDIVISION AMITY ESTATE STAGES 1 & 2 NARANGBA			
STATE: QLD		REGION:	
FSA:	SAM:	ADA:	
PROJECT No:		AYCA-4GKXKP	
CADREF No:		E17-P.2660551.D.01N	
SCALE 1:500 @ A1	SHEET 2	OF 3	REV. 0



Development Information

Development Name:

AMITY ESTATE

Developer Company:

POINTCORP

Development Address:

CALLAGHAN RD NARANGBA

Authorised Rep:

TOBY SKEATES

Phone:

3271 2911

E-Mail:

toby.skeates@jpr.com.au

CRM ID:

AYCA-4GKXKP

Stage Number:

1 & 2

BILL OF MATERIAL

NO OF LOTS:95

PITS

DUCTS

SIZE	QTY	SIZE	QTY	MTRS
2	13	P100	39	1334.3
5	20	P50	14	291.4
6	4	P23	93	562
8	7			
9	0			

TOTAL NUMBER OF PITS:

44

TOTAL NUMBER OF MANHOLES:


0

TOTAL NUMBER OF CONDUITS:

146

TOTAL LENGTH OF CONDUITS:

2187.7

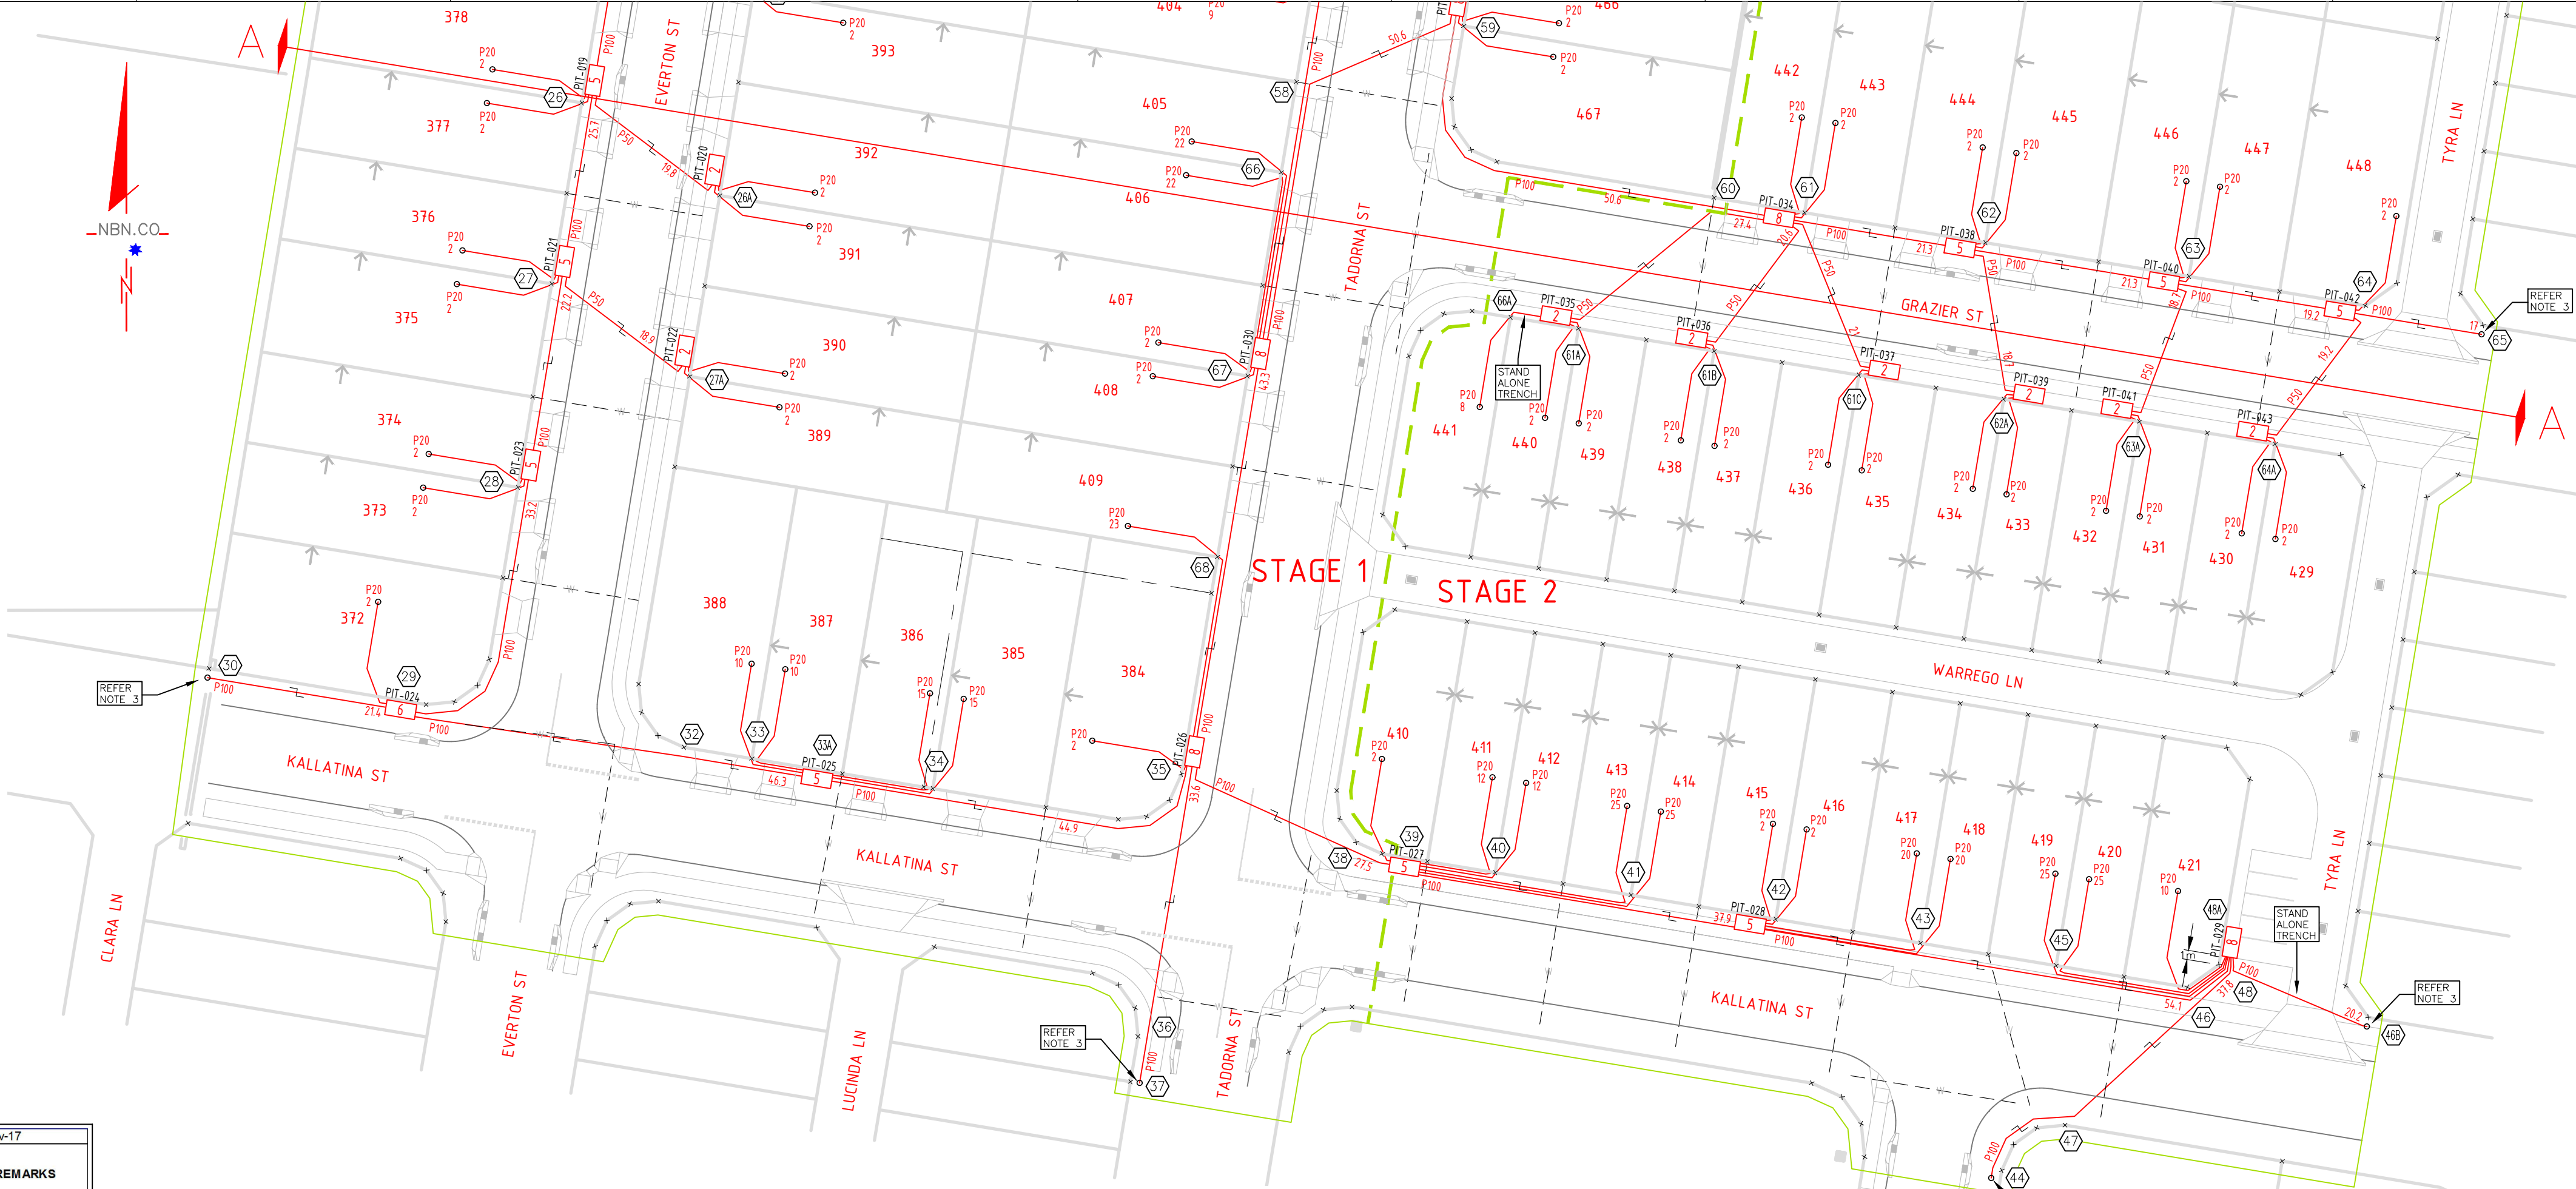

File Name:-P.Z660551.D.01N.xls										NBN CO. CONDUIT SCHEDULE										DATE: 24-Nov-17	
LOCATION	STATIONS FROM - TO	NBN CO. CONDUIT LENGTH (m)					NBN CO. BENDS (Deg/No)					X-SECTION (m)			PROTECTIVE COVER REQUIRED	DRAW WIRE	KERB MARK	REMARKS			
		23mm	No	50mm	No	100mm	No	23mm		50mm		100mm		EXCAVATION							
								90	30	45	90	15	22.5						30		
CALLAGHAN RD	1-2					77	1					1	2					ROAD CROSSING			
TADORNA ST	2-6											1	1			79					
	6-7											2	2					ROAD CROSSING			
	7-10					37	1					2	2	2		37					
	7-11	10	2			10	1					1	2			10					
VENUS ST	11-13A					34	1					1	1			34					
	13A-50											1	3					ROAD CROSSING			
TADORNA ST	50-14					6	2								6			ROAD CROSSING			
VENUS ST	14-15					30	2								30		18				
	15-17	30	2														128				
	17-18												4					ROAD CROSSING			
	18-21					58	1								58		60				
EVERTON ST	17-22					22	1						2	2		22		24			
	22-23											2	4								
	23-29					135	1					3	2	135		137		ROAD CROSSING			
	25-25A								2	2								ROAD CROSSING			
KALLATINA ST	25-25B									2	1							ROAD CROSSING			
	26-26A									3	1							ROAD CROSSING			
	27-27A										3	1						ROAD CROSSING			
	29-30					24	1							24			26				
VENUS ST	29-32																				
	32-33					8	1							8			10				
	33-34	20	2			20	1						2	20		66					
	34-35					30	1					2	2	30		32		ROAD CROSSING			
KALLATINA ST	35-36																				
	36-37					5	1							5		7					
	35-38											2	2					ROAD CROSSING			
	38-39					4	1					1		4			6				
VENUS ST	39-40	13	4			13	1							13			75				
	40-41	15	2			15	1							15			51				
	41-42					16	1							16			18				
	42-43	16	2			16	1							16			54				
TADORNA ST	43-45					15	1							15			17				
	45-46	15	2			15	1						2	15			51				
	46-48	5	3			5	2							5			35				
	46-47											1	1					ROAD CROSSING			
VENUS ST	47-44					10	1					1	2	10			12				
	48-46B													1				ROAD CROSSING			
	48-48A	1	3			1	3					1	2	1			18				
	50-55					109	1							109			111				
TADORNA ST	51-51A								3	2								ROAD CROSSING			
	52-52A									3	2							ROAD CROSSING			
	53-53A										3	2						ROAD CROSSING			
	53A-53B	10	1											10				STAND ALONE (ALIGN = 900-2250)			
TADORNA ST	14-56					40	1					2	2	40			42				
	56-57A									4								ROAD CROSSING			
	57A-57B	3	2	3	1									3				STAND ALONE (ALIGN = 900-2250)			
	56-57	9	2			9	1							9			33				
TADORNA ST / GRAZIER ST	57-58					10	1							10			12				
	58-59												4					ROAD CROSSING			
	59-60					42	1					2	2	42			44				
	60-61A									2											
GRAZIER ST	61A-66A	8	1											8			10				
	60-61													10			24				
	61-61B									3		1						ROAD CROSSING			
	61-61C									4								ROAD CROSSING			
TADORNA ST	61-65					75	1							75			77				
	62-62A										2	2						ROAD CROSSING			
	63-63A										3	2						ROAD CROSSING			
	64-64A										3		1					ROAD CROSSING			
TADORNA ST	65-66					10	2							10			24				
	66-67	23	2			23	2							23			100				
	67-68					20	1							20			22				
	68-69	24	1			24	1							24			52				
VARIOUS LOCATIONS	SPS LEAD IN								93					166			372				
	MPS LEAD IN																1611				
TOTAL CIVIL			580	13	1054	93	36	14	7	25	7	40	1185	0	1611	0					

File Name:-P.Z660551.D.01N.xls										NBN CO.CIVIL CONDUIT SCHEDULE					DATE: 24-Nov-17	
LOCATION	STATIONS FROM - TO	NBN CO. CONDUIT LENGTH (m)			X-SECTION (m)	PLUGS	DRAW WIRE	KERB MARK	REMARKS							
		50mm	No	100mm						No						
CALLAGHAN RD	1-2			28	1	28	2	30	2	CIVIL CONTRACTOR TO SUPPLY & INSTALL CROSS ROAD CONDUITS						
TADORNA ST	6-7			27	1	27	2	29	2	CIVIL CONTRACTOR TO SUPPLY & INSTALL CROSS ROAD CONDUITS						
VENUS ST	13A-50			18	1	18	2	20	2	CIVIL CONTRACTOR TO SUPPLY & INSTALL CROSS ROAD CONDUITS						
TADORNA ST	50-14			29	1	29	2	31	2	CIVIL CONTRACTOR TO SUPPLY & INSTALL CROSS ROAD CONDUITS						
VENUS ST	17-18			16	1	16	2	18	2	CIVIL CONTRACTOR TO SUPPLY & INSTALL CROSS ROAD CONDUITS						
EVERTON ST	22-23			17	1	17	2	19	2	CIVIL CONTRACTOR TO SUPPLY & INSTALL CROSS ROAD CONDUITS						
	25-25A	18	1			18	2	20	2	CIVIL CONTRACTOR TO SUPPLY & INSTALL CROSS ROAD CONDUITS						
	25-25B	21	1			21	2	23	2	CIVIL CONTRACTOR TO SUPPLY & INSTALL CROSS ROAD CONDUITS						
	26-26A	19	1			19	2	21	2	CIVIL CONTRACTOR TO SUPPLY & INSTALL CROSS ROAD CONDUITS						
	27-27A	19	1			19	2	21	2	CIVIL CONTRACTOR TO SUPPLY & INSTALL CROSS ROAD CONDUITS						
	29-32			29	1	29	2	31	2	CIVIL CONTRACTOR TO SUPPLY & INSTALL CROSS ROAD CONDUITS						
KALLATINA ST	35-36			29	1	29	2	31	2	CIVIL CONTRACTOR TO SUPPLY & INSTALL CROSS ROAD CONDUITS						
	35-38			21	1	21	2	23	2	CIVIL CONTRACTOR TO SUPPLY & INSTALL CROSS ROAD CONDUITS						
	46-47			20	1	20	2	22	2	CIVIL CONTRACTOR TO SUPPLY & INSTALL CROSS ROAD CONDUITS						
	48-46B			18	1	18	2	20	2	CIVIL CONTRACTOR TO SUPPLY & INSTALL CROSS ROAD CONDUITS						
VENUS ST	51-51A	17	1			17	2	19	2	CIVIL CONTRACTOR TO SUPPLY & INSTALL CROSS ROAD CONDUITS						
	52-52A	17	1			17	2	19	2	CIVIL CONTRACTOR TO SUPPLY & INSTALL CROSS ROAD CONDUITS						
	53-53A	17	1			17	2	19	2	CIVIL CONTRACTOR TO SUPPLY & INSTALL CROSS ROAD CONDUITS						
TADORNA ST	56-57A	20	1			20	2	22	2	CIVIL CONTRACTOR TO SUPPLY & INSTALL CROSS ROAD CONDUITS						
	58-59			20	1	20	2	22	2	CIVIL CONTRACTOR TO SUPPLY & INSTALL CROSS ROAD CONDUITS						
GRAZIER ST	60-61A	21	1			21	2	23	2	CIVIL CONTRACTOR TO SUPPLY & INSTALL CROSS ROAD CONDUITS						
	61-61B	18	1			18	2	20	2	CIVIL CONTRACTOR TO SUPPLY & INSTALL CROSS ROAD CONDUITS						
	61-61C	19	1			19	2	21	2	CIVIL CONTRACTOR TO SUPPLY & INSTALL CROSS ROAD CONDUITS						
	62-62A	18	1			18	2	20	2	CIVIL CONTRACTOR TO SUPPLY & INSTALL CROSS ROAD CONDUITS						
	63-63A	17	1			17	2	19	2	CIVIL CONTRACTOR TO SUPPLY & INSTALL CROSS ROAD CONDUITS						
	64-64A	18	1			18	2	20	2	CIVIL CONTRACTOR TO SUPPLY & INSTALL CROSS ROAD CONDUITS						
TOTAL CIVIL		259		272		531	52	583	52							

AS CONSTRUCTED

"ISSUED FOR CONSTRUCTION"  
SIGN. *Steve Harte*.....03/11/17

SOURCE DOCUMENTS			
AUTHOR	DRG. No.	REV. No.	DATE
RMA	170308 11124 DESIGN STRINGS - PHASE 1DWG	-	24-03-17
-	-	-	-
-	-	-	-
REV	DATE	DRAFTER	DESCRIPTION	APPROVED
D	16-05-18	P.H./I.T.J.	AS CONSTRUCTED	
C	03-11-17	S.H./I.T.J.	ISSUED FOR CONSTRUCTION & AMEND ROAD CROSSING AT STN'S 13A-50	
B	12-09-17	A.Mc./I.T.J.	APPROVED BY NBN Co INCLUDING ROAD ANEMS	
A	18-07-17	T.S./I.T.J.	ADD PIT AT STN 2	
-	31-05-17	T.S./B.H.	ORIGINAL ISSUE	

STRICTLY CONFIDENTIAL

NBNCO APPROVAL RECORD:

☐ DD

☐ WD

☐ AB


SIGNATURE

DATE


QUALITY RECORD :

NBNCO DISCLAIMER

THIS DOCUMENT HAS BEEN PREPARED SOLELY FOR THE USE OF NBNCO LIMITED (ABN 86 136 533 741) FOR USE IN MAINTAINING NBNCO FACILITIES. IT HAS NOT BEEN CREATED FOR ANY OTHER USE. IT SHOULD NOT BE SCALED TO LOCATE NBNCO ASSETS. NO WARRANTY IS GIVEN THAT THE INFORMATION IS ACCURATE OR COMPLETE.




Australia's broadband network

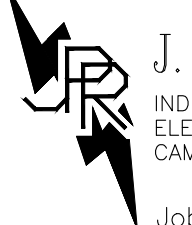

J. & P. RICHARDSON INDUSTRIES PTY LTD A.C.N. 001 952 325 ELECTRICAL CONTRACTORS AND ENGINEERS CAMPBELL AVE WACOL Ph (07)3271 2911

Job No: P.Z660551.D.01

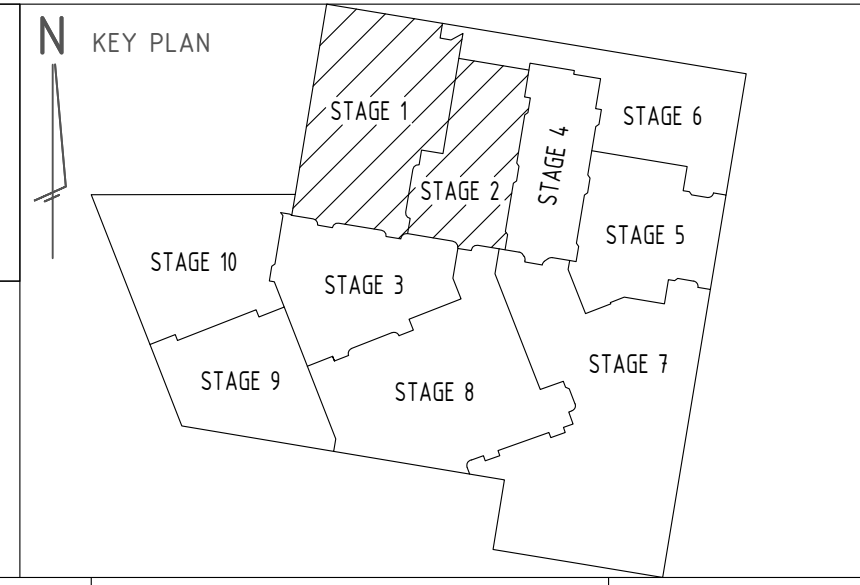

DRAWING TITLE:  
NBN Co. PIT & PIPE INFRASTRUCTURE  
TO PROPOSED SUBDIVISION  
AMITY ESTATE STAGES 1 & 2  
NARANGBA

STATE: QLD REGION:

FSA: SAM: ADA:

PROJECT No: AYCA-4GKXKP

CADREF No: E17-P.Z660551.D.01N

SCALE 1:500 @ A1 SHEET No. 3 OF 3 REV. D

