


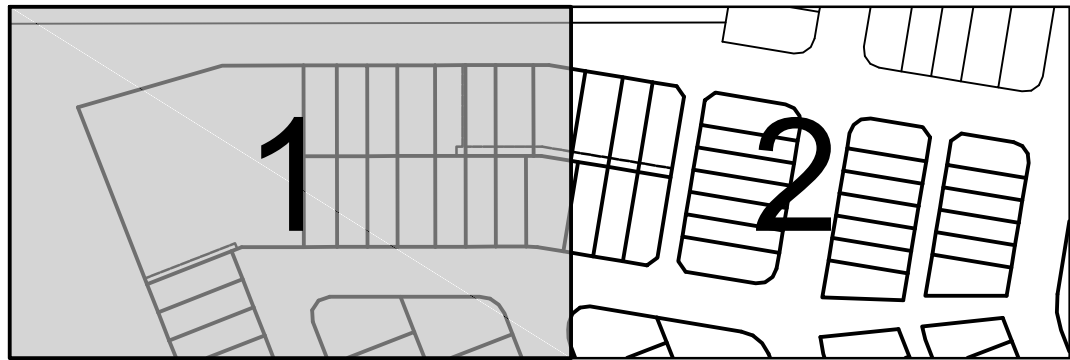

KEY PLAN
Scale 1: 2500


COORDINATE DATUM NOTE:

Horizontal coordinates (E, N) supplied are MGA Zone 56, based on GDA 94.
Horizontal datum derived from PSM52870
E 496223.382 N 6992682.075


Levels supplied are on AHD
Level datum derived from PSM 52870 RL 44.140m (AHD)

All distances shown on this plan are at MGA scale.
(Combined scale factor 0.9996)

1. All pipes are 375Ø Class '2' Reinforced Concrete Pipes (RCP) unless noted otherwise.
2. All manholes are 1050Ø with Cast Iron, Circular lids, unless noted otherwise.
3. All gully pits are "Type A" gully on a 1050Ø manhole, unless noted otherwise.
(For Drainway Gully Pits, see detail below)
4. All Field Pits are 600x600 with Galvanised Grated lids unless noted otherwise.
5. All bedding to pipes is Type '3' unless noted otherwise.
6. Year of construction 2019.

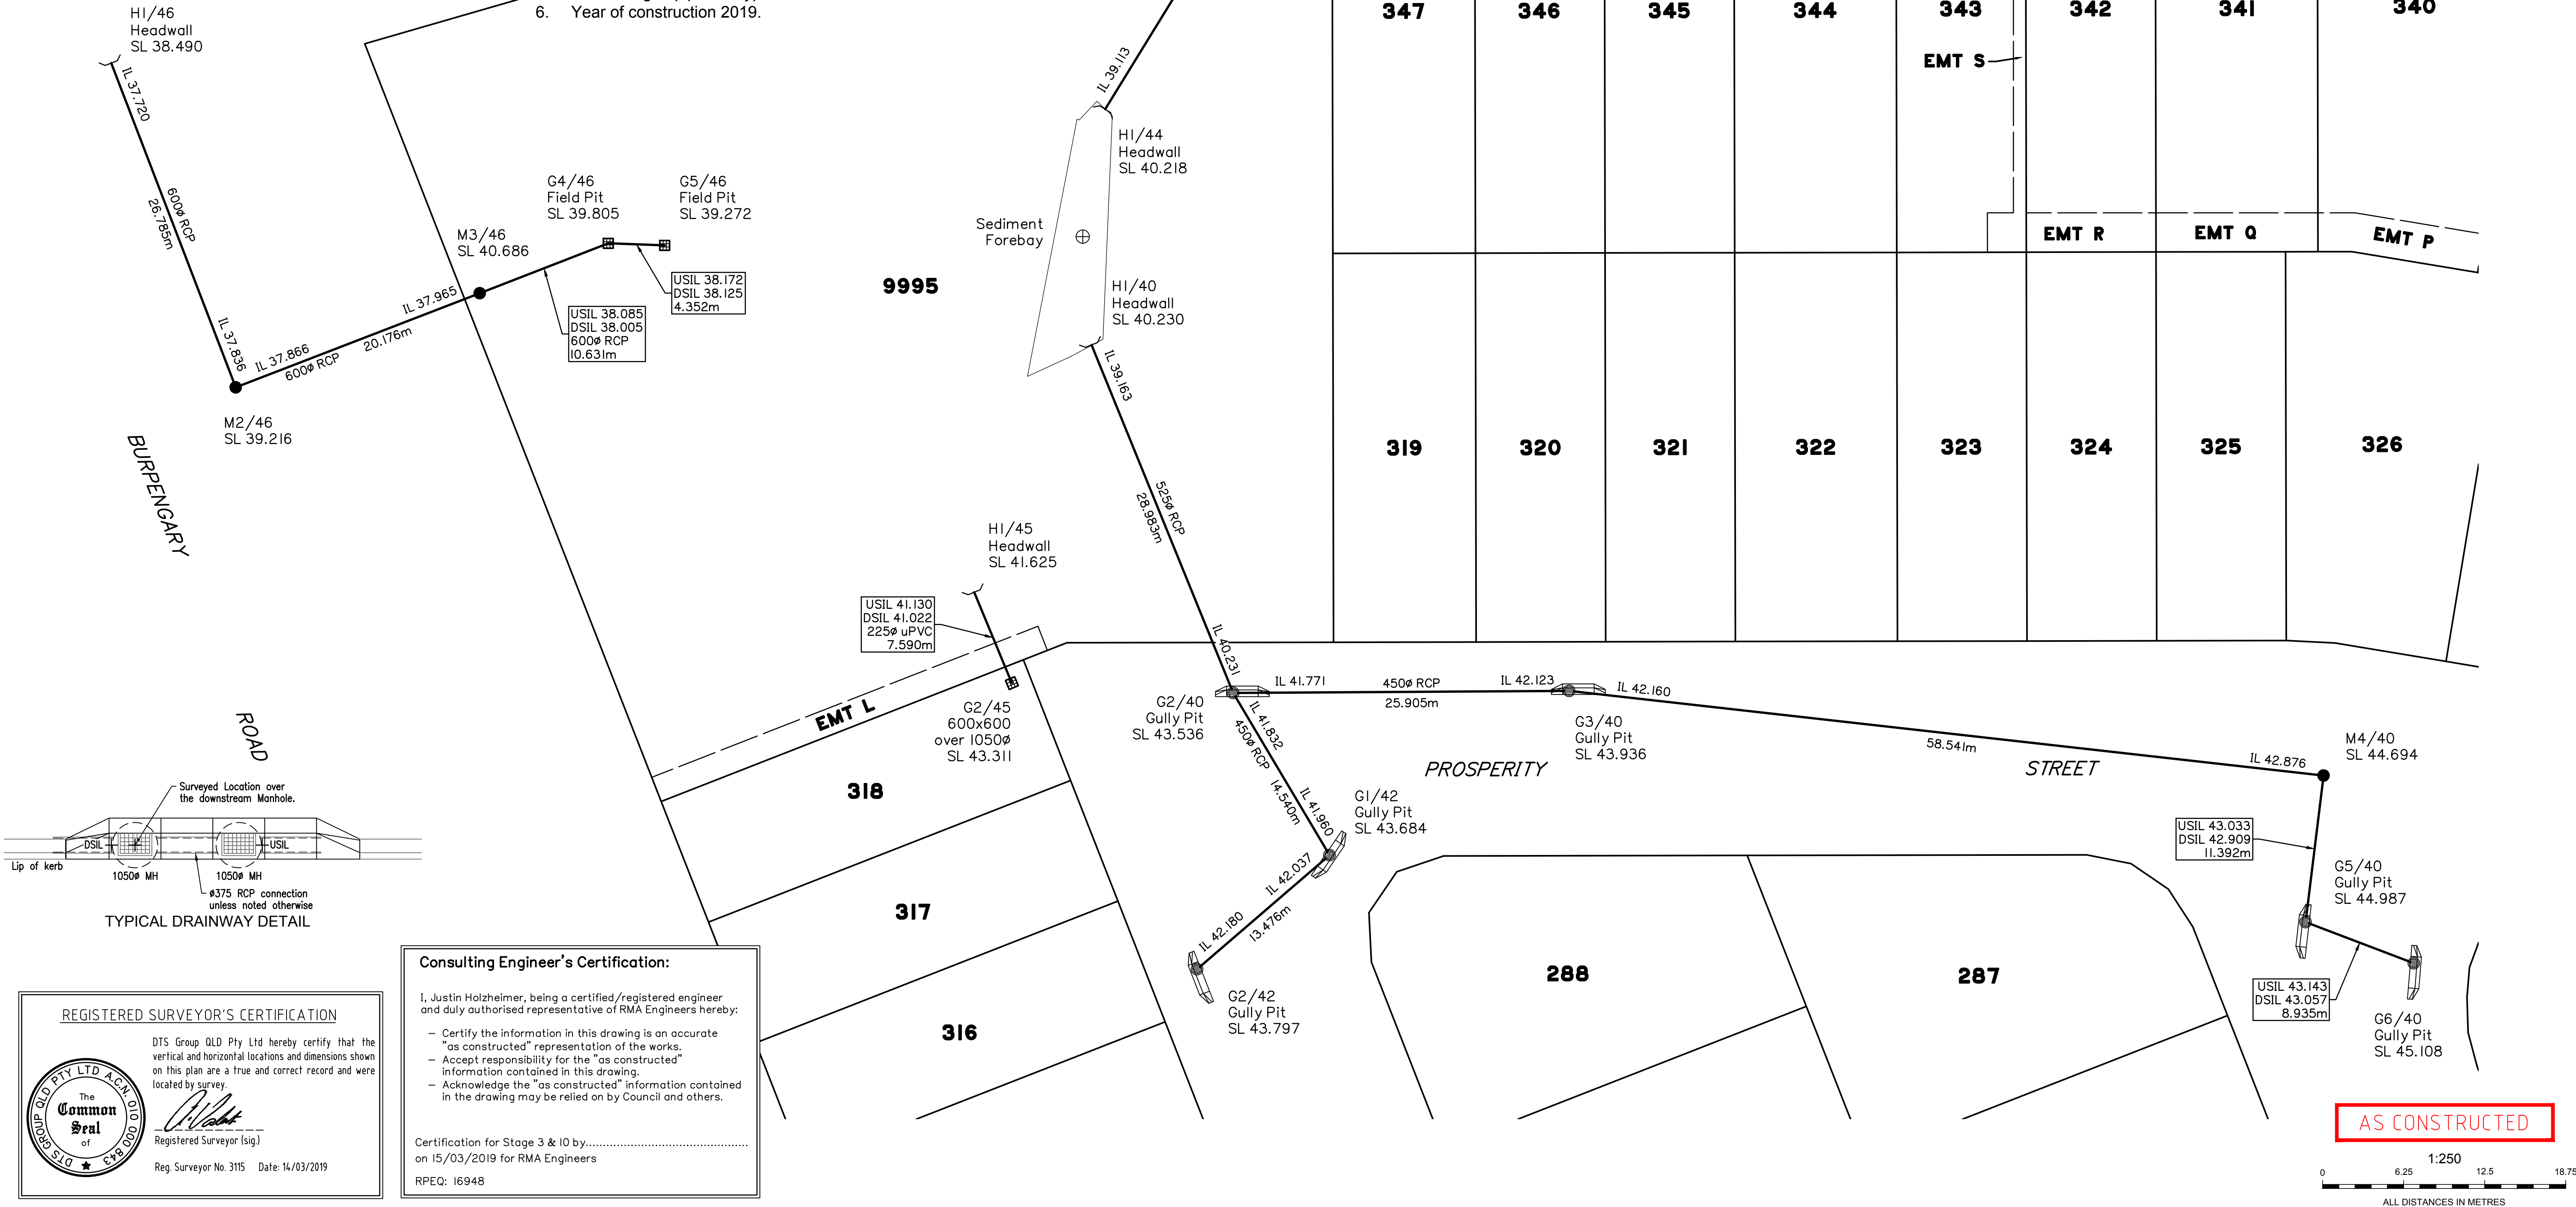

AS CONSTRUCTED

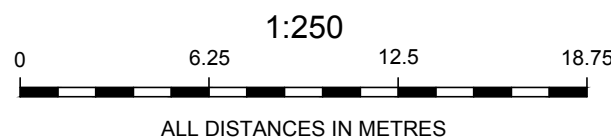

ISSUE	DATE	REVISIONS	DRAWN	CHECKED	PASSED
A	14/03/2019	AS CONSTRUCTED - ORIGINAL ISSUE	AA	JPS	TL

Urban planning, surveying & development

Brisbane
PO Box 3128, West End QLD 4101
Ph: 07 3118 0800
brisbane@dtsgd.com.au

Mackay
PO Box 11711, Mackay Caneland QLD 4740
Ph: 1300 278 783
mackay@dtsgd.com.au

DRAWN	AA	14/03/2019
CHECKED	JPS	14/03/2019
PASSED	TL	14/03/2019
INITIALS	DATE	




Moreton Bay Regional Council

Real Property Description
Lots 251-256, 348-371 & 9998 on SP298950 and
Lots 257-260, 284-292, 311-347, 1003 & 9995 on SP298957
Locality of Narangba
Datum for Levels PM 52870 RL 44.140m AHD

Amity Estate
Stages 3 & 10
Burpengary & Callaghan Roads,
Narangba

AS CONSTRUCTED DRAINAGE

SCALE	1:250 (A1)
DTS Ref:	BNE150725
DRAWING No.	A1-1304-D-1
SHEET	1 of 2 SHEETS

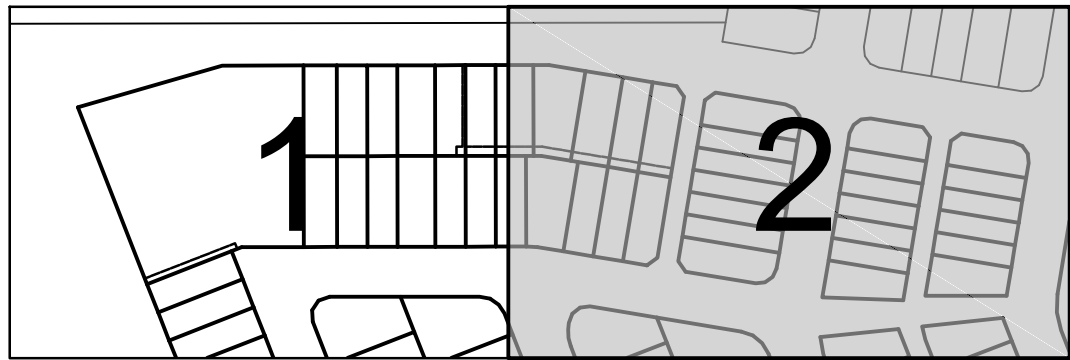

KEY PLAN
Scale 1: 2500


COORDINATE DATUM NOTE:

Horizontal coordinates (E, N) supplied are MGA Zone 56, based on GDA 94.
Horizontal datum derived from PSM52870
E 496223.382 N 6992682.075

Levels supplied are on AHD
Level datum derived from PSM 52870 RL 44.140m (AHD)

All distances shown on this plan are at MGA scale.
(Combined scale factor 0.9996)

- All pipes are 375Ø Class '2' Reinforced Concrete Pipes (RCP) unless noted otherwise.
- All manholes are 1050Ø with Cast Iron, Circular lids, unless noted otherwise.
- All gully pits are "Type A" gully on a 1050Ø manhole, unless noted otherwise.
(For Drainway Gully Pits, see detail below)
- All Field Pits are 600x600 with Galvanised Grated lids unless noted otherwise.
- All bedding to pipes is Type '3' unless noted otherwise.
- Year of construction 2019.

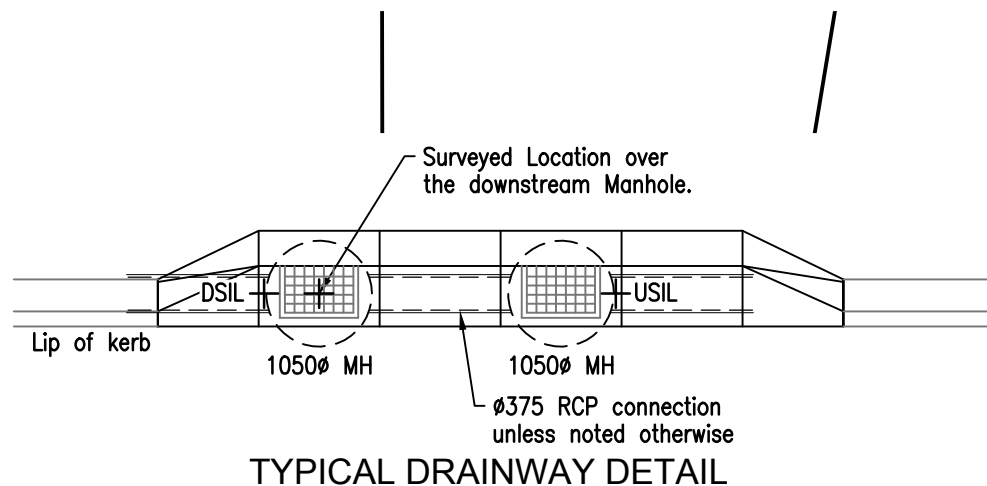

125

326

327

328

329

PROSPERITY

258

257

KALLATINA

338

337

336

335

334

333

332

331

330

STREET

EVERTON

STREET

STREET

348

349

350

351

352

353

354

355

PATHWAY

386

385

384

371

370

369

368

367

366

PATHWAY

365

TADORNA

Consulting Engineer's Certification:

I, Justin Halzheimer, being a certified/registered engineer and duly authorised representative of RMA Engineers hereby:

- Certify the information in this drawing is an accurate "as constructed" representation of the works.
- Accept responsibility for the "as constructed" information contained in this drawing.
- Acknowledge the "as constructed" information contained in the drawing may be relied on by Council and others.

Certification for Stage 3 & 10 by.....
on 15/03/2019 for RMA Engineers
RPEQ: 16948

REGISTERED SURVEYOR'S CERTIFICATION

DTS Group QLD Pty Ltd hereby certify that the vertical and horizontal locations and dimensions shown on this plan are a true and correct record and were located by survey.

 The Common Seal of DTS GROUP QLD PTY LTD A/CN 010010010
Registered Surveyor (sig.)
Reg. Surveyor No. 3115 Date: 14/03/2019

AS CONSTRUCTED

1:250
0 6.25 12.5 18.75
ALL DISTANCES IN METRES

ISSUE	DATE	AS CONSTRUCTED - ORIGINAL ISSUE	REVISIONS	DRAWN	CHECKED	PASSED
A	14/03/2019	AS CONSTRUCTED - ORIGINAL ISSUE	AA	JPS	TL	

 **dts** urban planning, surveying & development

Brisbane PO Box 3128, West End QLD 4101
Mackay PO Box 11711, Mackay Queensland QLD 4740
Ph: 07 3118 0800
brisbane@dtsqld.com.au
mackay@dtsqld.com.au

INITIALS	DATE
DRAWN AA	14/03/2019
CHECKED JPS	14/03/2019
PASSED TL	14/03/2019



Moreton Bay Regional Council


Real Property Description
Lots 251-256, 348-371 & 9998 on SP298950 and
Lots 257-260, 284-292, 311-347, 1003 & 9995 on SP298957
Locality of Narangba
Datum for Levels PM 52870 RL 44.140m AHD

Amity Estate
Stages 3 & 10
Burpengary & Callaghan Roads,
Narangba

AS CONSTRUCTED DRAINAGE

SCALE	1:250 (A1)
DTS Ref:	BNE150725
DRAWING No.	A1-1304-D-1
SHEET	2 of 2 SHEETS

Mar 14, 2019 - 2:44pm

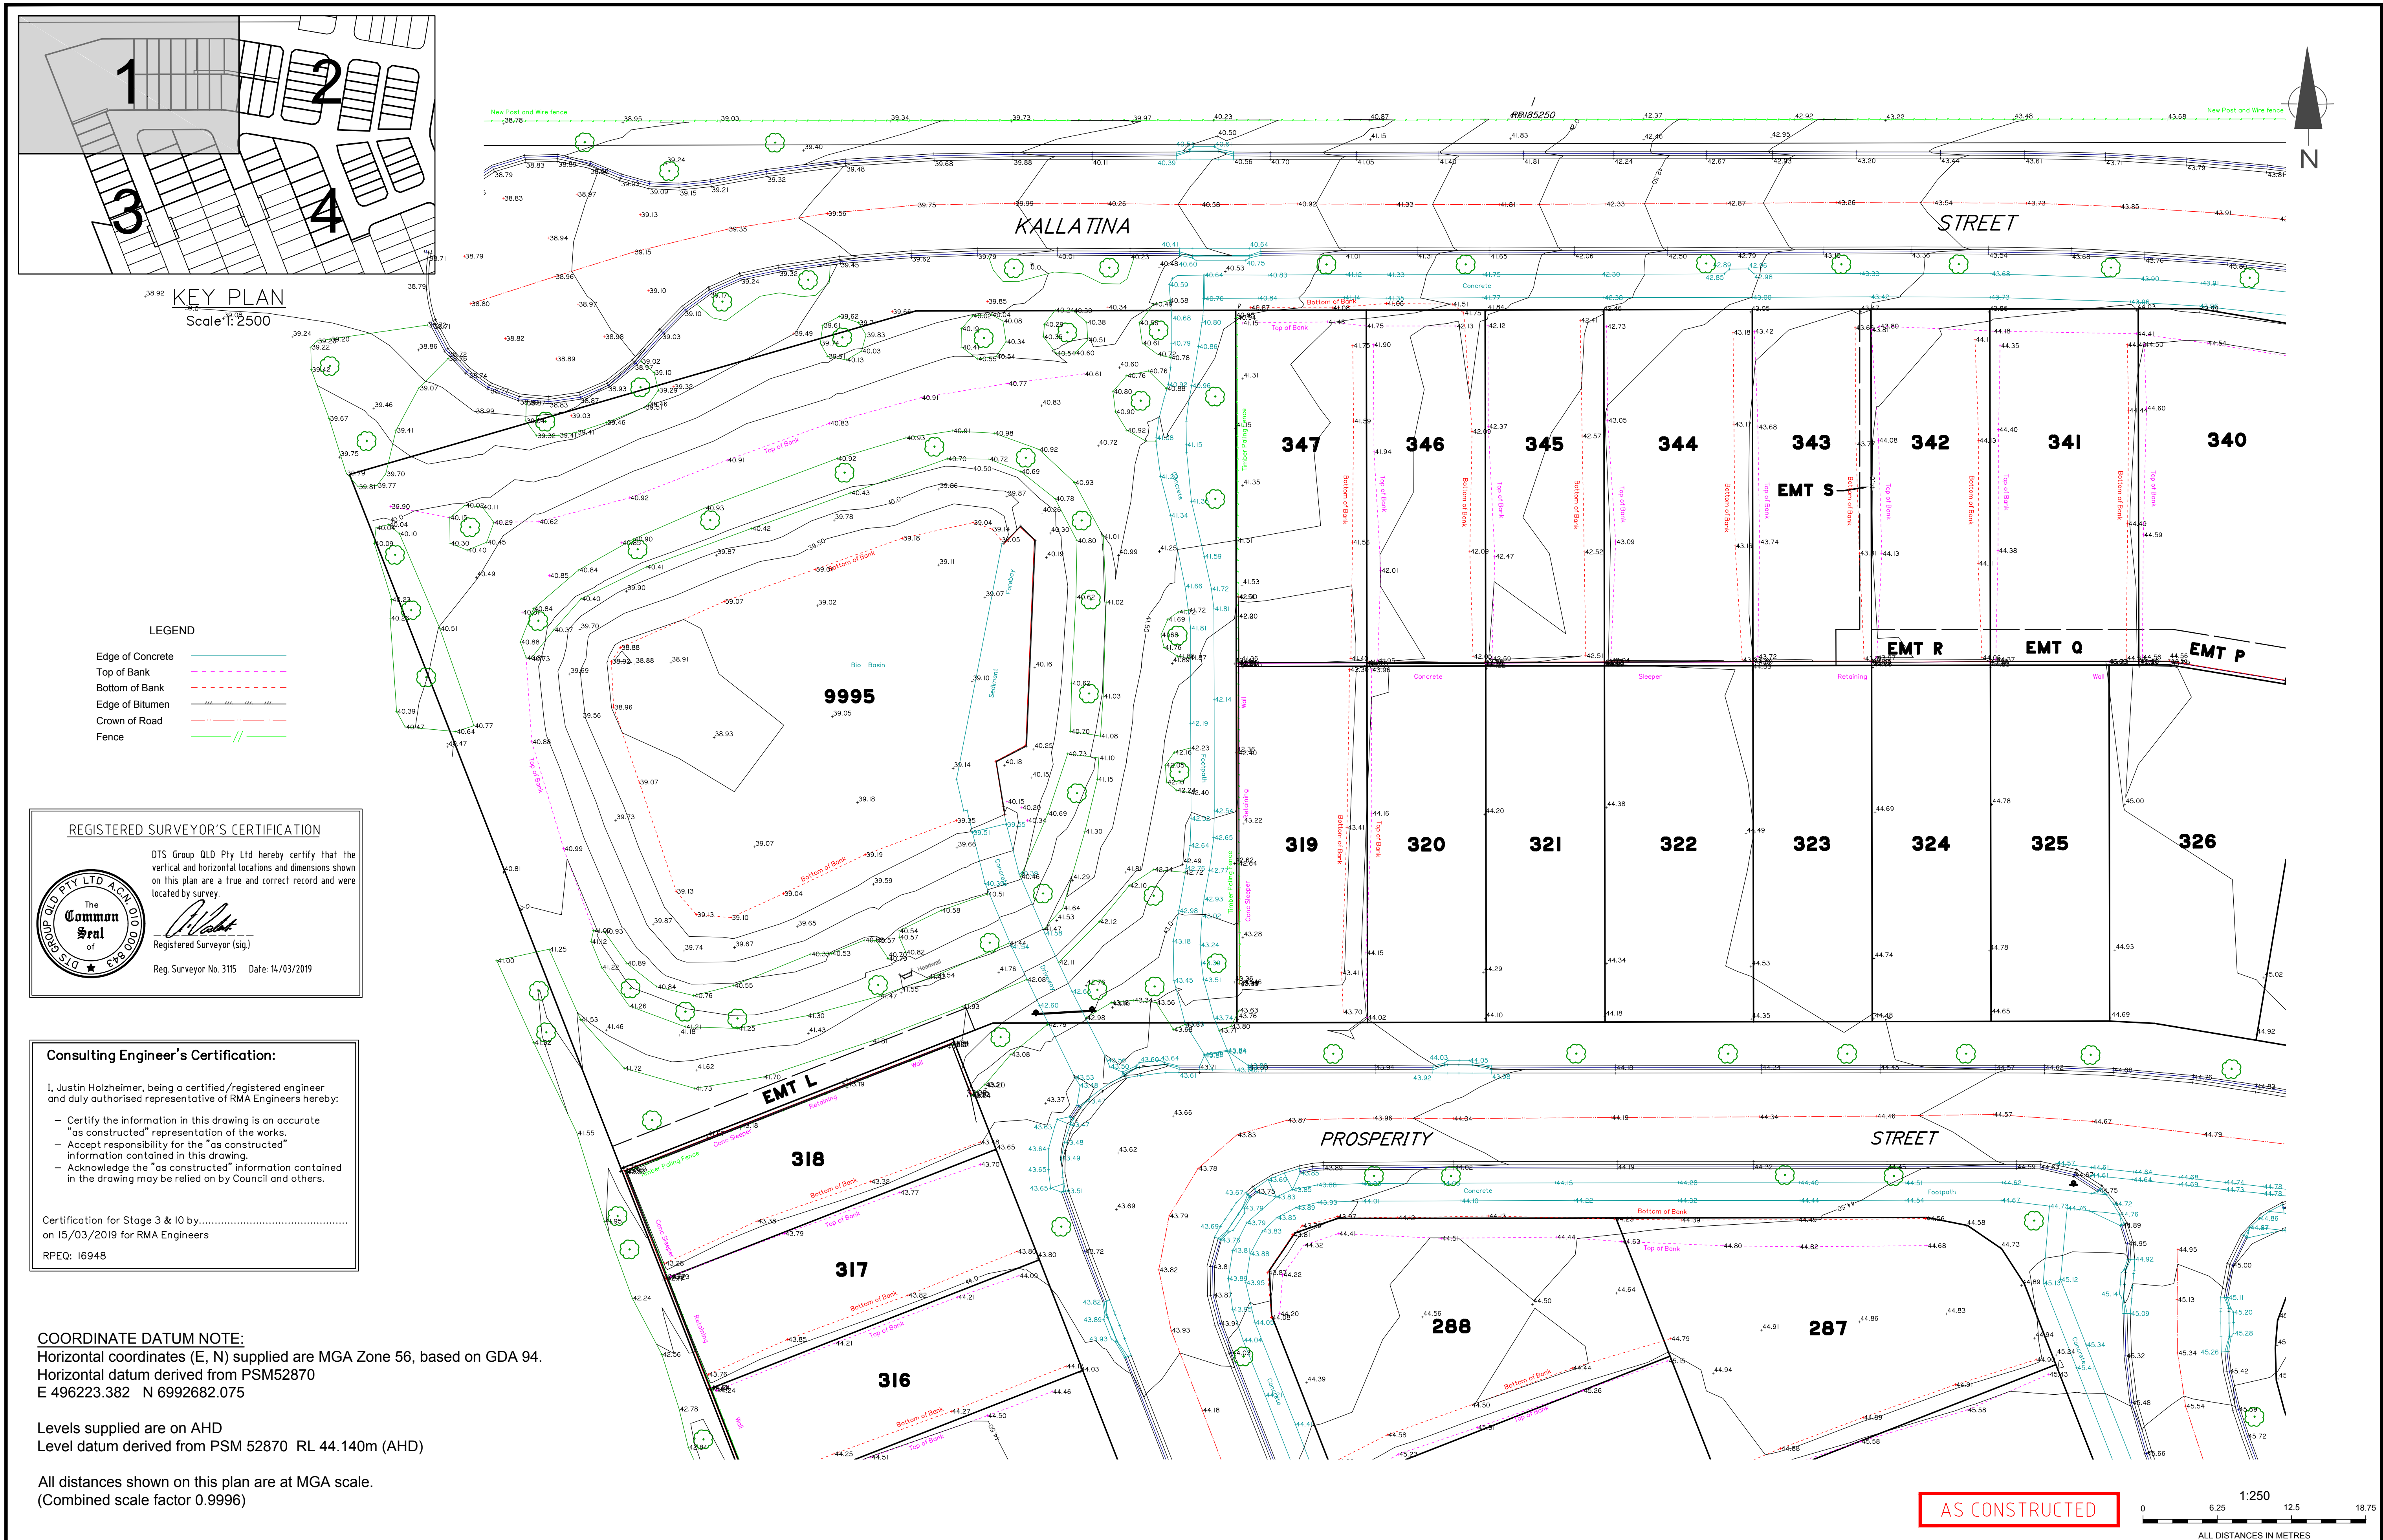

ISSUE	DATE	AS CONSTRUCTED - ORIGINAL ISSUE	REVISIONS	DRAWN	CHECKED	PASSED
A	14/03/2019	AS CONSTRUCTED - ORIGINAL ISSUE		AA	JPS	TL

dts urban planning, surveying & development

Brisbane
PO Box 3128, West End QLD 4101
Ph: 07 3118 0800
brisbane@dtsqld.com.au

Mackay
PO Box 11711, Mackay Caneland QLD 4740
Ph: 1300 278 783
mackay@dtsqld.com.au

DRAWN	AA	14/03/2019
CHECKED	JPS	14/03/2019
PASSED	TL	14/03/2019
INITIALS	DATE	



Moreton Bay Regional Council

Real Property Description
Lots 251-256, 348-371 & 9998 on SP298950 and
Lots 257-260, 284-292, 311-347, 1003 & 9995 on SP298957
Locality of Narangba
Datum for Levels PM 52870 RL 44.140m AHD

Amity Estate
Stages 3 & 10
Burgupary & Callaghan Roads,
Narangba

AS CONSTRUCTED CONTOURS

SCALE	1:250 (A1)
DTS Ref:	BNE150725
DRAWING No.	A1-1304-C-1
SHEET	1 of 4 SHEETS

COORDINATE DATUM NOTE:
Horizontal coordinates (E, N) supplied are MGA Zone 56, based on GDA 94.
Horizontal datum derived from PSM52870
E 496223.382 N 6992682.075

Levels supplied are on AHD
Level datum derived from PSM 52870 RL 44.140m (AHD)



All distances shown on this plan are at MGA scale.
(Combined scale factor 0.9996)

REGISTERED SURVEYOR'S CERTIFICATION

DTS Group QLD Pty Ltd hereby certify that the vertical and horizontal locations and dimensions shown on this plan are a true and correct record and were located by survey.

 The Common Seal of DTS Group QLD Pty Ltd
Registered Surveyor (sig.)
Reg. Surveyor No. 3115 Date: 14/03/2019

- LEGEND
- Edge of Concrete
 - Top of Bank
 - Bottom of Bank
 - Edge of Bitumen
 - Crown of Road
 - Fence

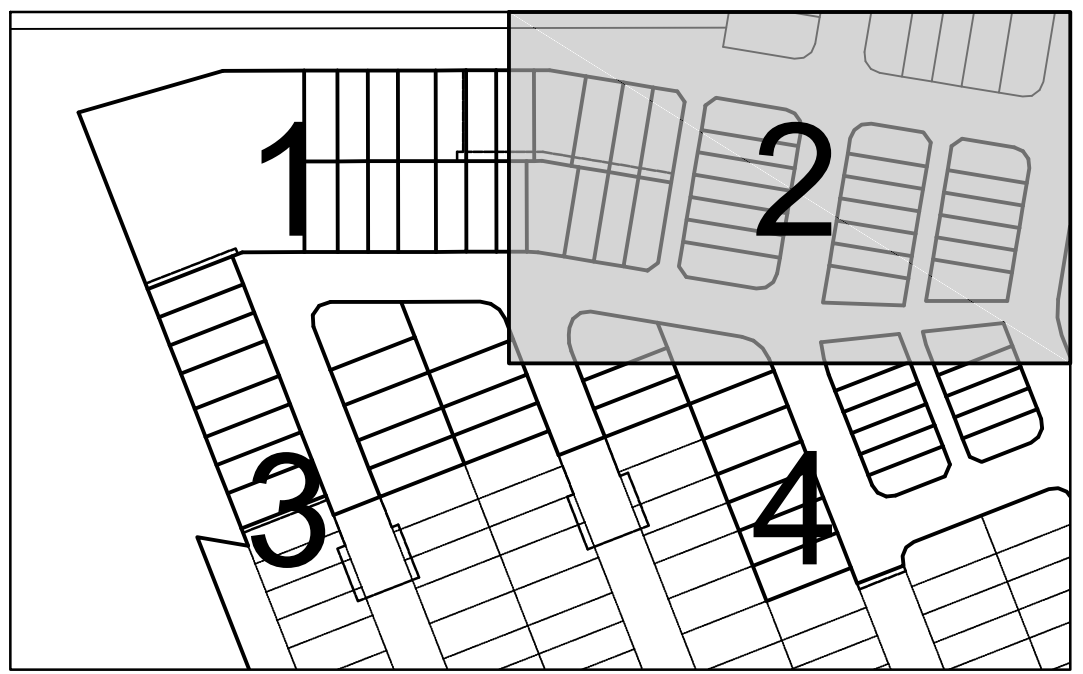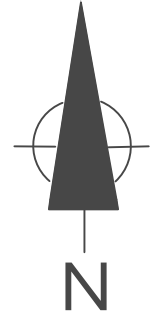


KEY PLAN
Scale 1:2500

Consulting Engineer's Certification:

I, Justin Holzheimer, being a certified/registered engineer and duly authorised representative of RMA Engineers hereby:

- Certify the information in this drawing is an accurate "as constructed" representation of the works.
- Accept responsibility for the "as constructed" information contained in this drawing.
- Acknowledge the "as constructed" information contained in the drawing may be relied on by Council and others.

Certification for Stage 3 & 10 by.....
on 15/03/2019 for RMA Engineers
RPEQ: 16948

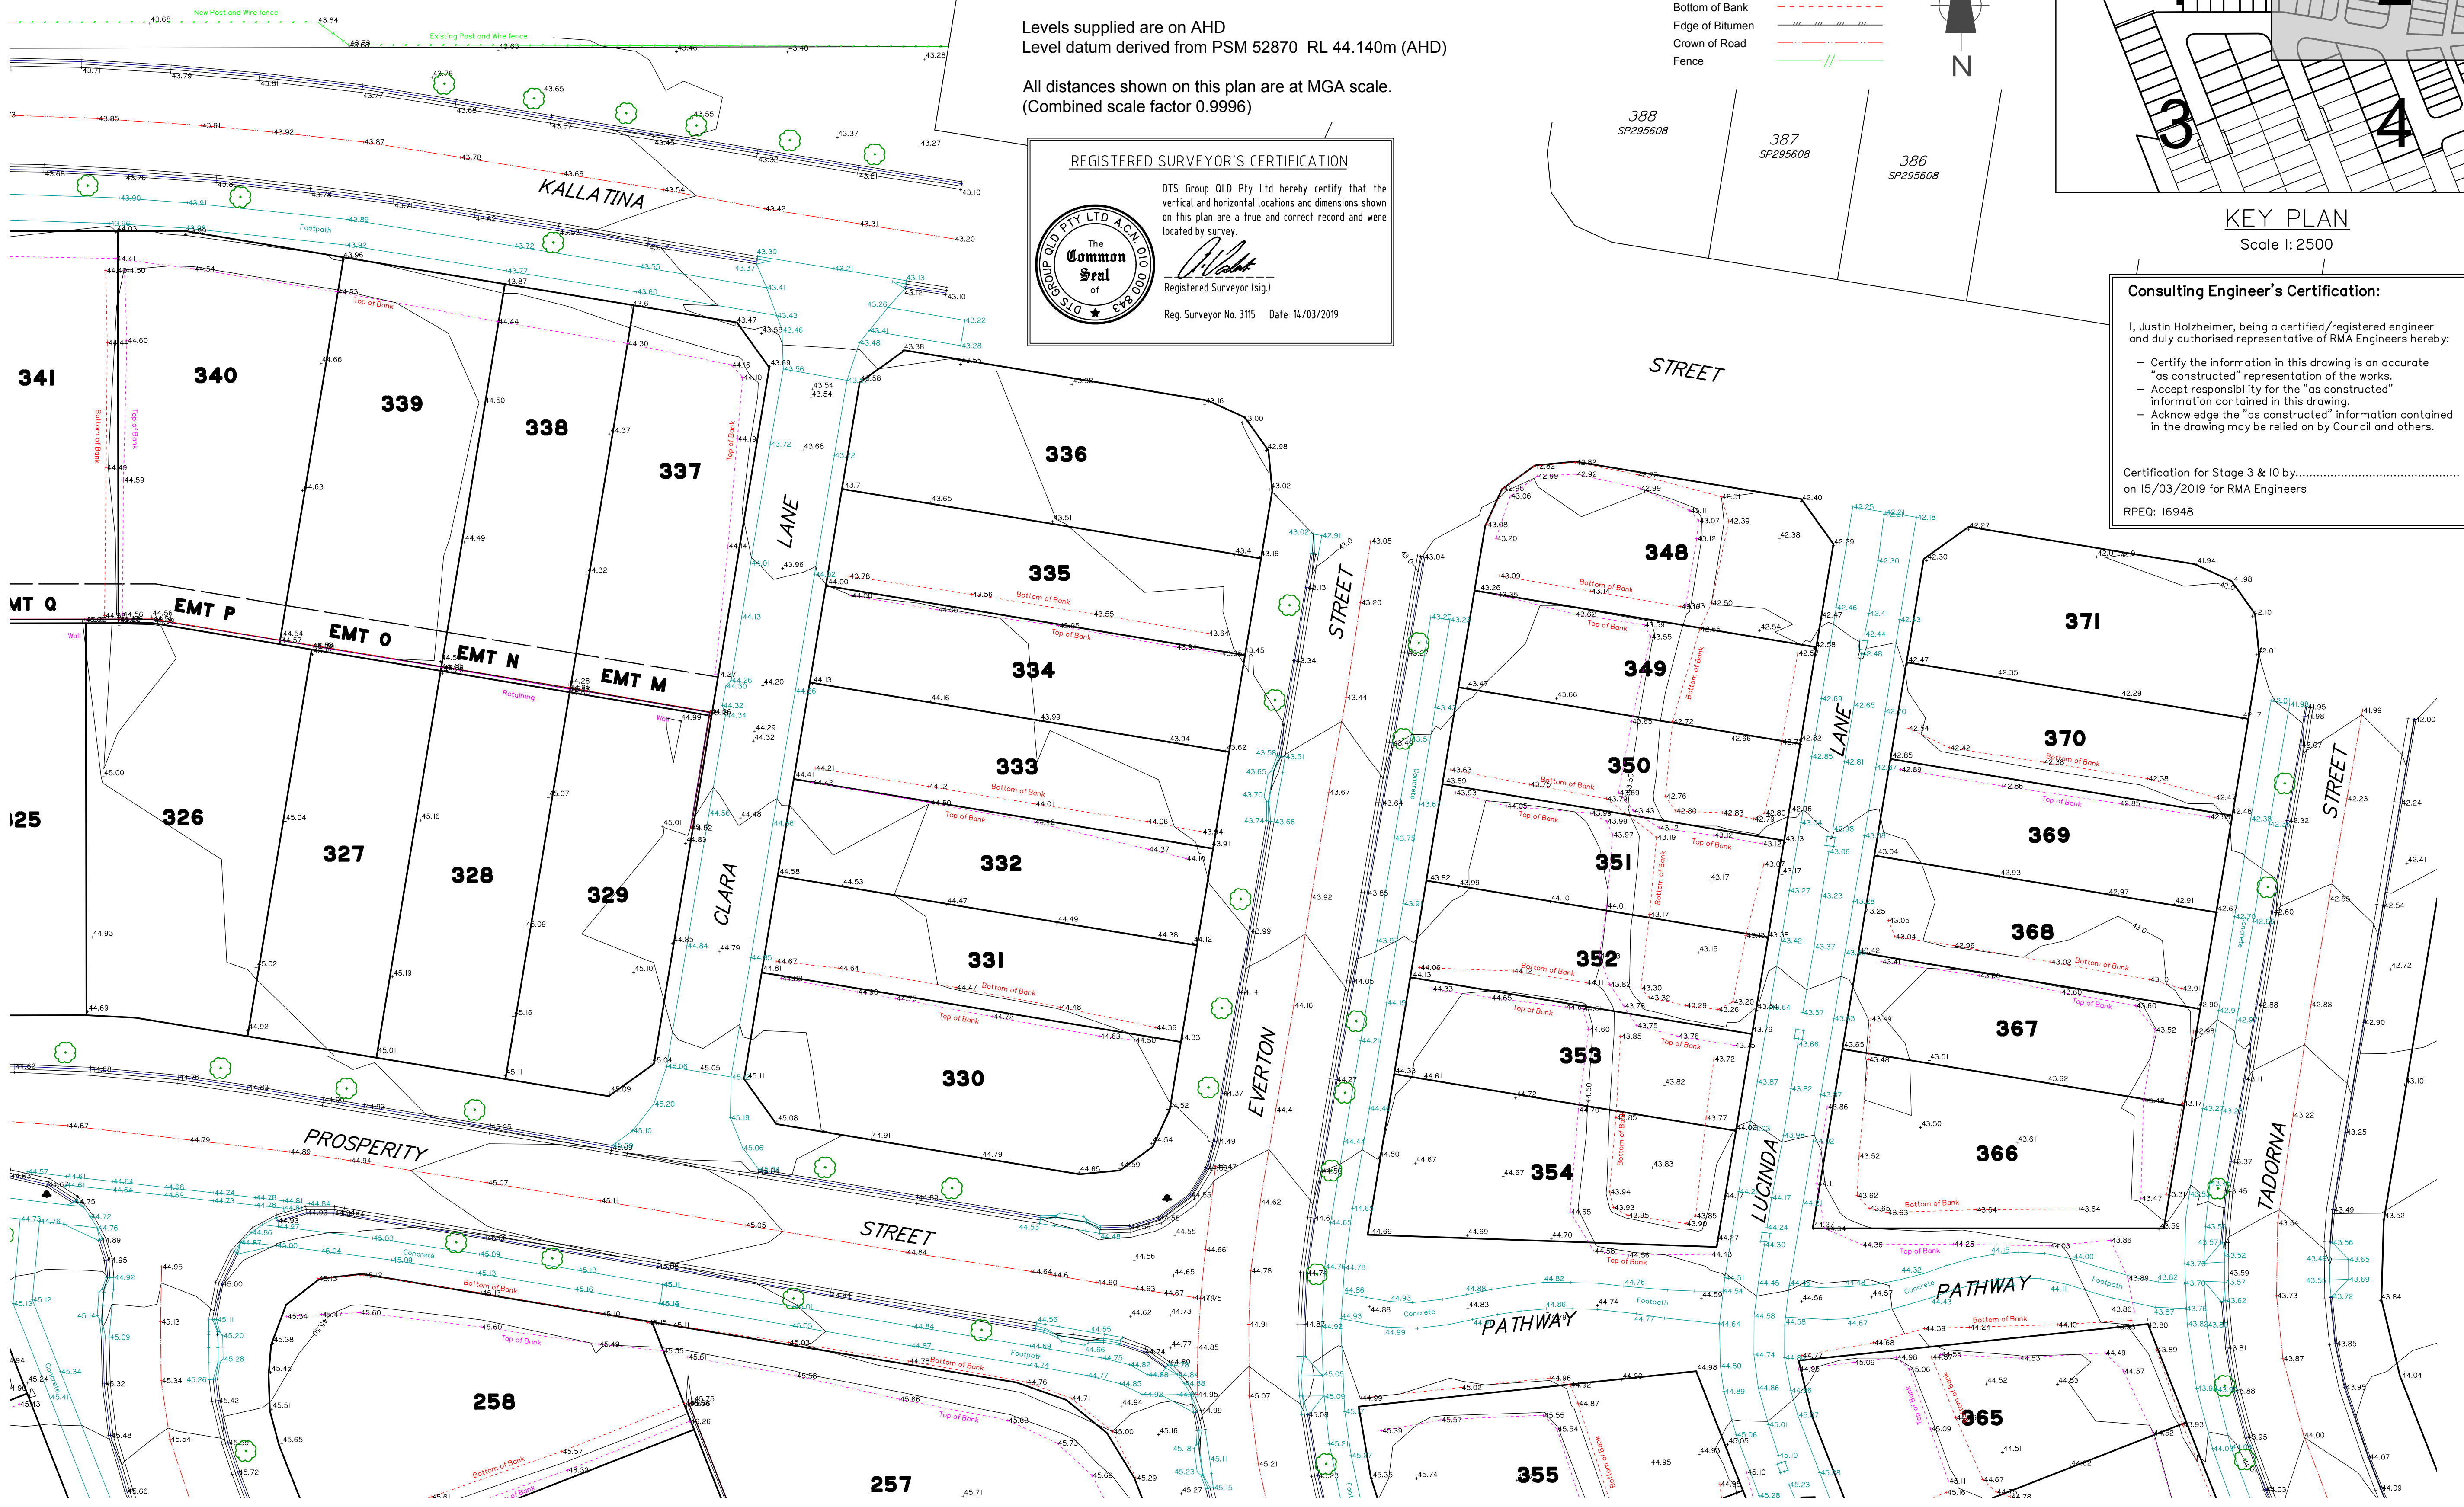

AS CONSTRUCTED

0 6.25 12.5 18.75

1:250

ALL DISTANCES IN METRES

ISSUE	DATE	REVISIONS	DRAWN	CHECKED	PASSED
A	14/03/2019	AS CONSTRUCTED - ORIGINAL ISSUE	AA	JPS	TL

 **dts** urban planning, surveying & development

Brisbane PO Box 3128, West End QLD 4101
Ph: 07 3118 0800
brisbane@dtsqld.com.au

Mackay PO Box 11711, Mackay Caneland QLD 4740
Ph: 1300 278 783
mackay@dtsqld.com.au

DRAWN	AA	14/03/2019
CHECKED	JPS	14/03/2019
PASSED	TL	14/03/2019
INITIALS		DATE




Moreton Bay Regional Council

Real Property Description
Lots 251-256, 348-371 & 998 on SP298950 and
Lots 257-260, 284-292, 311-347, 1003 & 995 on SP298957
Locality of Narangba
Datum for Levels PM 52870 RL 44.140m AHD

Amity Estate
Stages 3 & 10
Burgupary & Callaghan Roads,
Narangba

AS CONSTRUCTED CONTOURS

SCALE	1:250 (A1)
DTS Ref:	BNE150725
DRAWING No.	A1-1304-C-2
SHEET	2 of 4 SHEETS

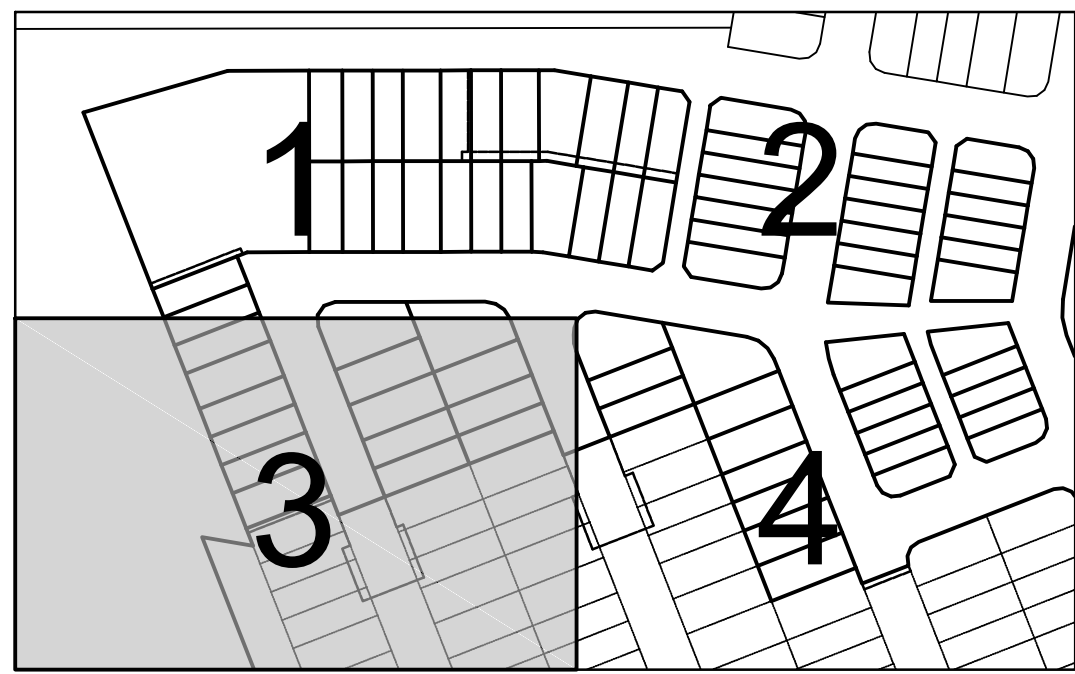

KEY PLAN
Scale 1:2500

COORDINATE DATUM NOTE:
Horizontal coordinates (E, N) supplied are MGA Zone 56, based on GDA 94.
Horizontal datum derived from PSM52870
E 496223.382 N 6992682.075

Levels supplied are on AHD
Level datum derived from PSM 52870 RL 44.140m (AHD)

All distances shown on this plan are at MGA scale.
(Combined scale factor 0.9996)

LEGEND

- Edge of Concrete
- Top of Bank
- Bottom of Bank
- Edge of Bitumen
- Crown of Road
- Fence

BURPENGARY

ROAD

PROSPERITY

STREET

TORRENIA

SILVER

N

Consulting Engineer's Certification:

I, Justin Holzheimer, being a certified/registered engineer and duly authorised representative of RMA Engineers hereby:

- Certify the information in this drawing is an accurate "as constructed" representation of the works.
- Accept responsibility for the "as constructed" information contained in this drawing.
- Acknowledge the "as constructed" information contained in the drawing may be relied on by Council and others.

Certification for Stage 3 & 10 by.....
on 15/03/2019 for RMA Engineers
RPEQ: 16948

REGISTERED SURVEYOR'S CERTIFICATION



DTS Group QLD Pty Ltd hereby certify that the vertical and horizontal locations and dimensions shown on this plan are a true and correct record and were located by survey

Registered Surveyor (sig.)

Reg. Surveyor No. 3115 Date: 14/03/2019

dts urban planning, surveying & development
Brisbane
PO Box 3128, West End QLD 4101
Ph: 07 3118 0600
brisbane@dtsqld.com.au
Mackay
PO Box 11711, Mackay Caneland QLD 4740
Ph: 1300 278 783
mackay@dtsqld.com.au

DRAWN	AA	14/03/2019
CHECKED	JPS	14/03/2019
PASSED	TL	14/03/2019
INITIALS	DATE	



Moreton Bay Regional Council


Real Property Description
Lots 251-256, 348-371 & 9998 on SP298950 and
Lots 257-260, 284-292, 311-347, 1003 & 9995 on SP298957
Locality of Narangba
Datum for Levels PM 52870 RL 44.140m AHD

Amity Estate
Stages 3 & 10
Burpengary & Callaghan Roads,
Narangba


AS CONSTRUCTED CONTOURS

SCALE	1:250 (A1)
DTS Ref:	BNE150725
DRAWING No.	A1-1304-C-3
SHEET	3 of 4 SHEETS

AS CONSTRUCTED

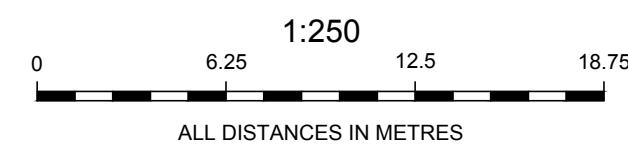

ISSUE	DATE	REVISIONS	DRAWN	CHECKED	PASSED
A	14/03/2019	AS CONSTRUCTED - ORIGINAL ISSUE	AA	JPS	TL

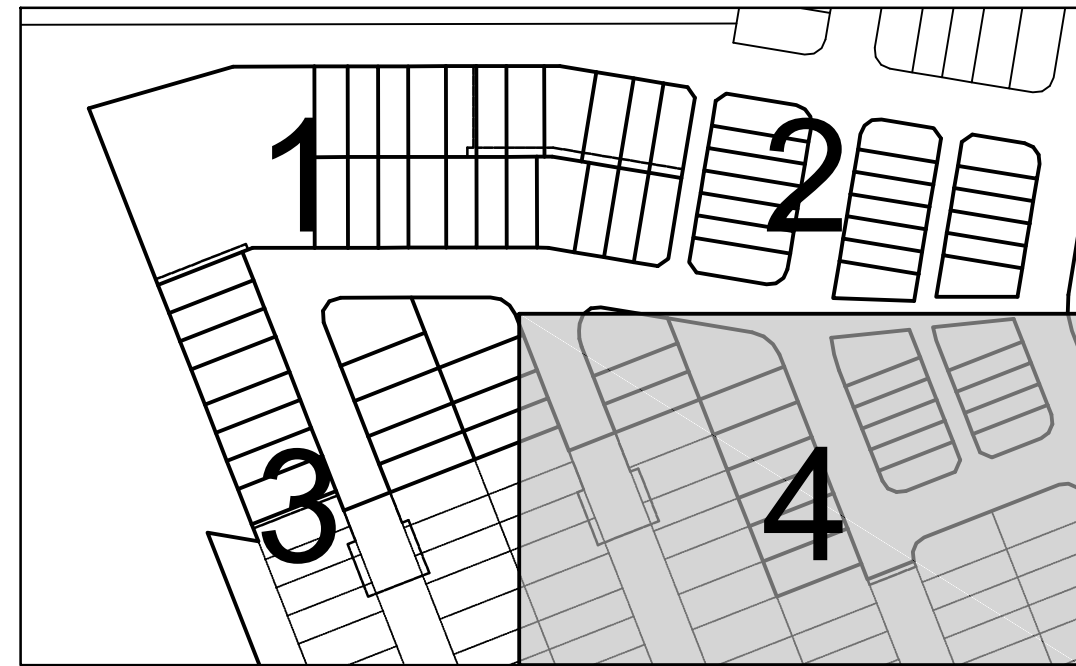

KEY PLAN
Scale 1:2500

COORDINATE DATUM NOTE:
Horizontal coordinates (E, N) supplied are MGA Zone 56, based on GDA 94.
Horizontal datum derived from PSM52870
E 496223.382 N 6992682.075

Levels supplied are on AHD
Level datum derived from PSM 52870 RL 44.140m (AHD)

All distances shown on this plan are at MGA scale.
(Combined scale factor 0.9996)

LEGEND

- Edge of Concrete
- Top of Bank
- Bottom of Bank
- Edge of Bitumen
- Crown of Road
- Fence

Consulting Engineer's Certification:

I, Justin Holzheimer, being a certified/registered engineer and duly authorised representative of RMA Engineers hereby:
- Certify the information in this drawing is an accurate "as constructed" representation of the works.
- Accept responsibility for the "as constructed" information contained in this drawing.
- Acknowledge the "as constructed" information contained in the drawing may be relied on by Council and others.

Certification for Stage 3 & 10 by.....
on 15/03/2019 for RMA Engineers
RPEQ: I6948

REGISTERED SURVEYOR'S CERTIFICATION



DTS Group QLD Pty Ltd hereby certify that the vertical and horizontal locations and dimensions shown on this plan are a true and correct record and were located by survey.

Registered Surveyor (Sig)
Reg. Surveyor No. 3115 Date: 14/03/2019

AS CONSTRUCTED



ISSUE	DATE	AS CONSTRUCTED - ORIGINAL ISSUE	REVISIONS	DRAWN	CHECKED	PASSED
A	14/03/2019	AS CONSTRUCTED - ORIGINAL ISSUE	AA	JPS	TL	

dts urban planning, surveying & development
Brisbane PO Box 3128, West End QLD 4101
Mackay PO Box 11711, Mackay Caneland QLD 4740
Ph: 07 3118 0800
brisbane@dtsqld.com.au
mackay@dtsqld.com.au

INITIALS	DATE
DRAWN AA	14/03/2019
CHECKED JPS	14/03/2019
PASSED TL	14/03/2019



Moreton Bay Regional Council

Real Property Description
Lots 251-256, 348-371 & 9998 on SP298950 and
Lots 257-260, 284-292, 311-347, 1003 & 9995 on SP298957
Locality of Narangba
Datum for Levels PM 52870 RL 44.140m AHD

Amity Estate
Stages 3 & 10
Burpengary & Callaghan Roads,
Narangba
AS CONSTRUCTED CONTOURS

SCALE	1:250 (A1)
DTS Ref:	BNE150725
DRAWING No.	A1-1304-C-4
SHEET	4 of 4 SHEETS