



**COORDINATE DATUM NOTE:**  
 HORIZONTAL COORDINATES(E,N) SUPPLIED ARE MAPPING GRID OF AUSTRALIA(MGA), ZONE 56 BASED ON THE UNIVERSAL TRANSVERSE MERCATOR PROJECTION AND THE GEOCENTRIC DATUM OF AUSTRALIA 1994.  
 HORIZONTAL DATUM DERIVED FROM PSM52870, E 496223.382, N 6992682.075.  
 LEVELS SUPPLIED ARE ON THE AUSTRALIAN HEIGHT DATUM(AHD)  
 LEVEL DATUM DERIVED FROM PSM52870 RL 44.140 (AHD)

PSM52870  
 E: 496223.382  
 N: 6992682.075  
 RL: 44.140m

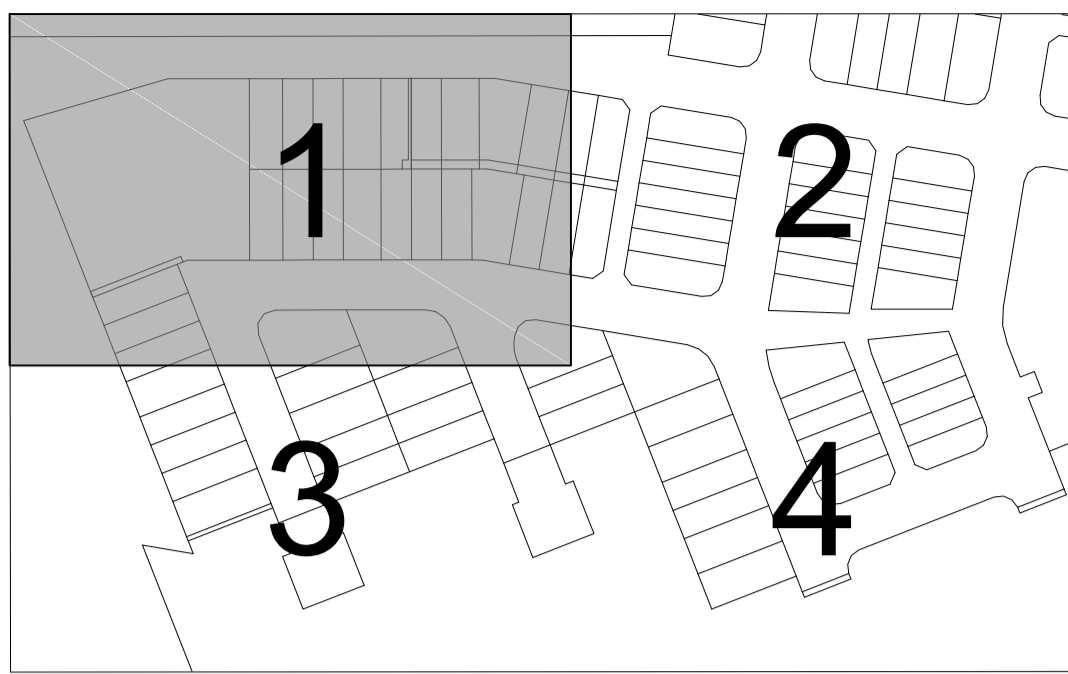


**KEY PLAN**  
 Scale 1:2500

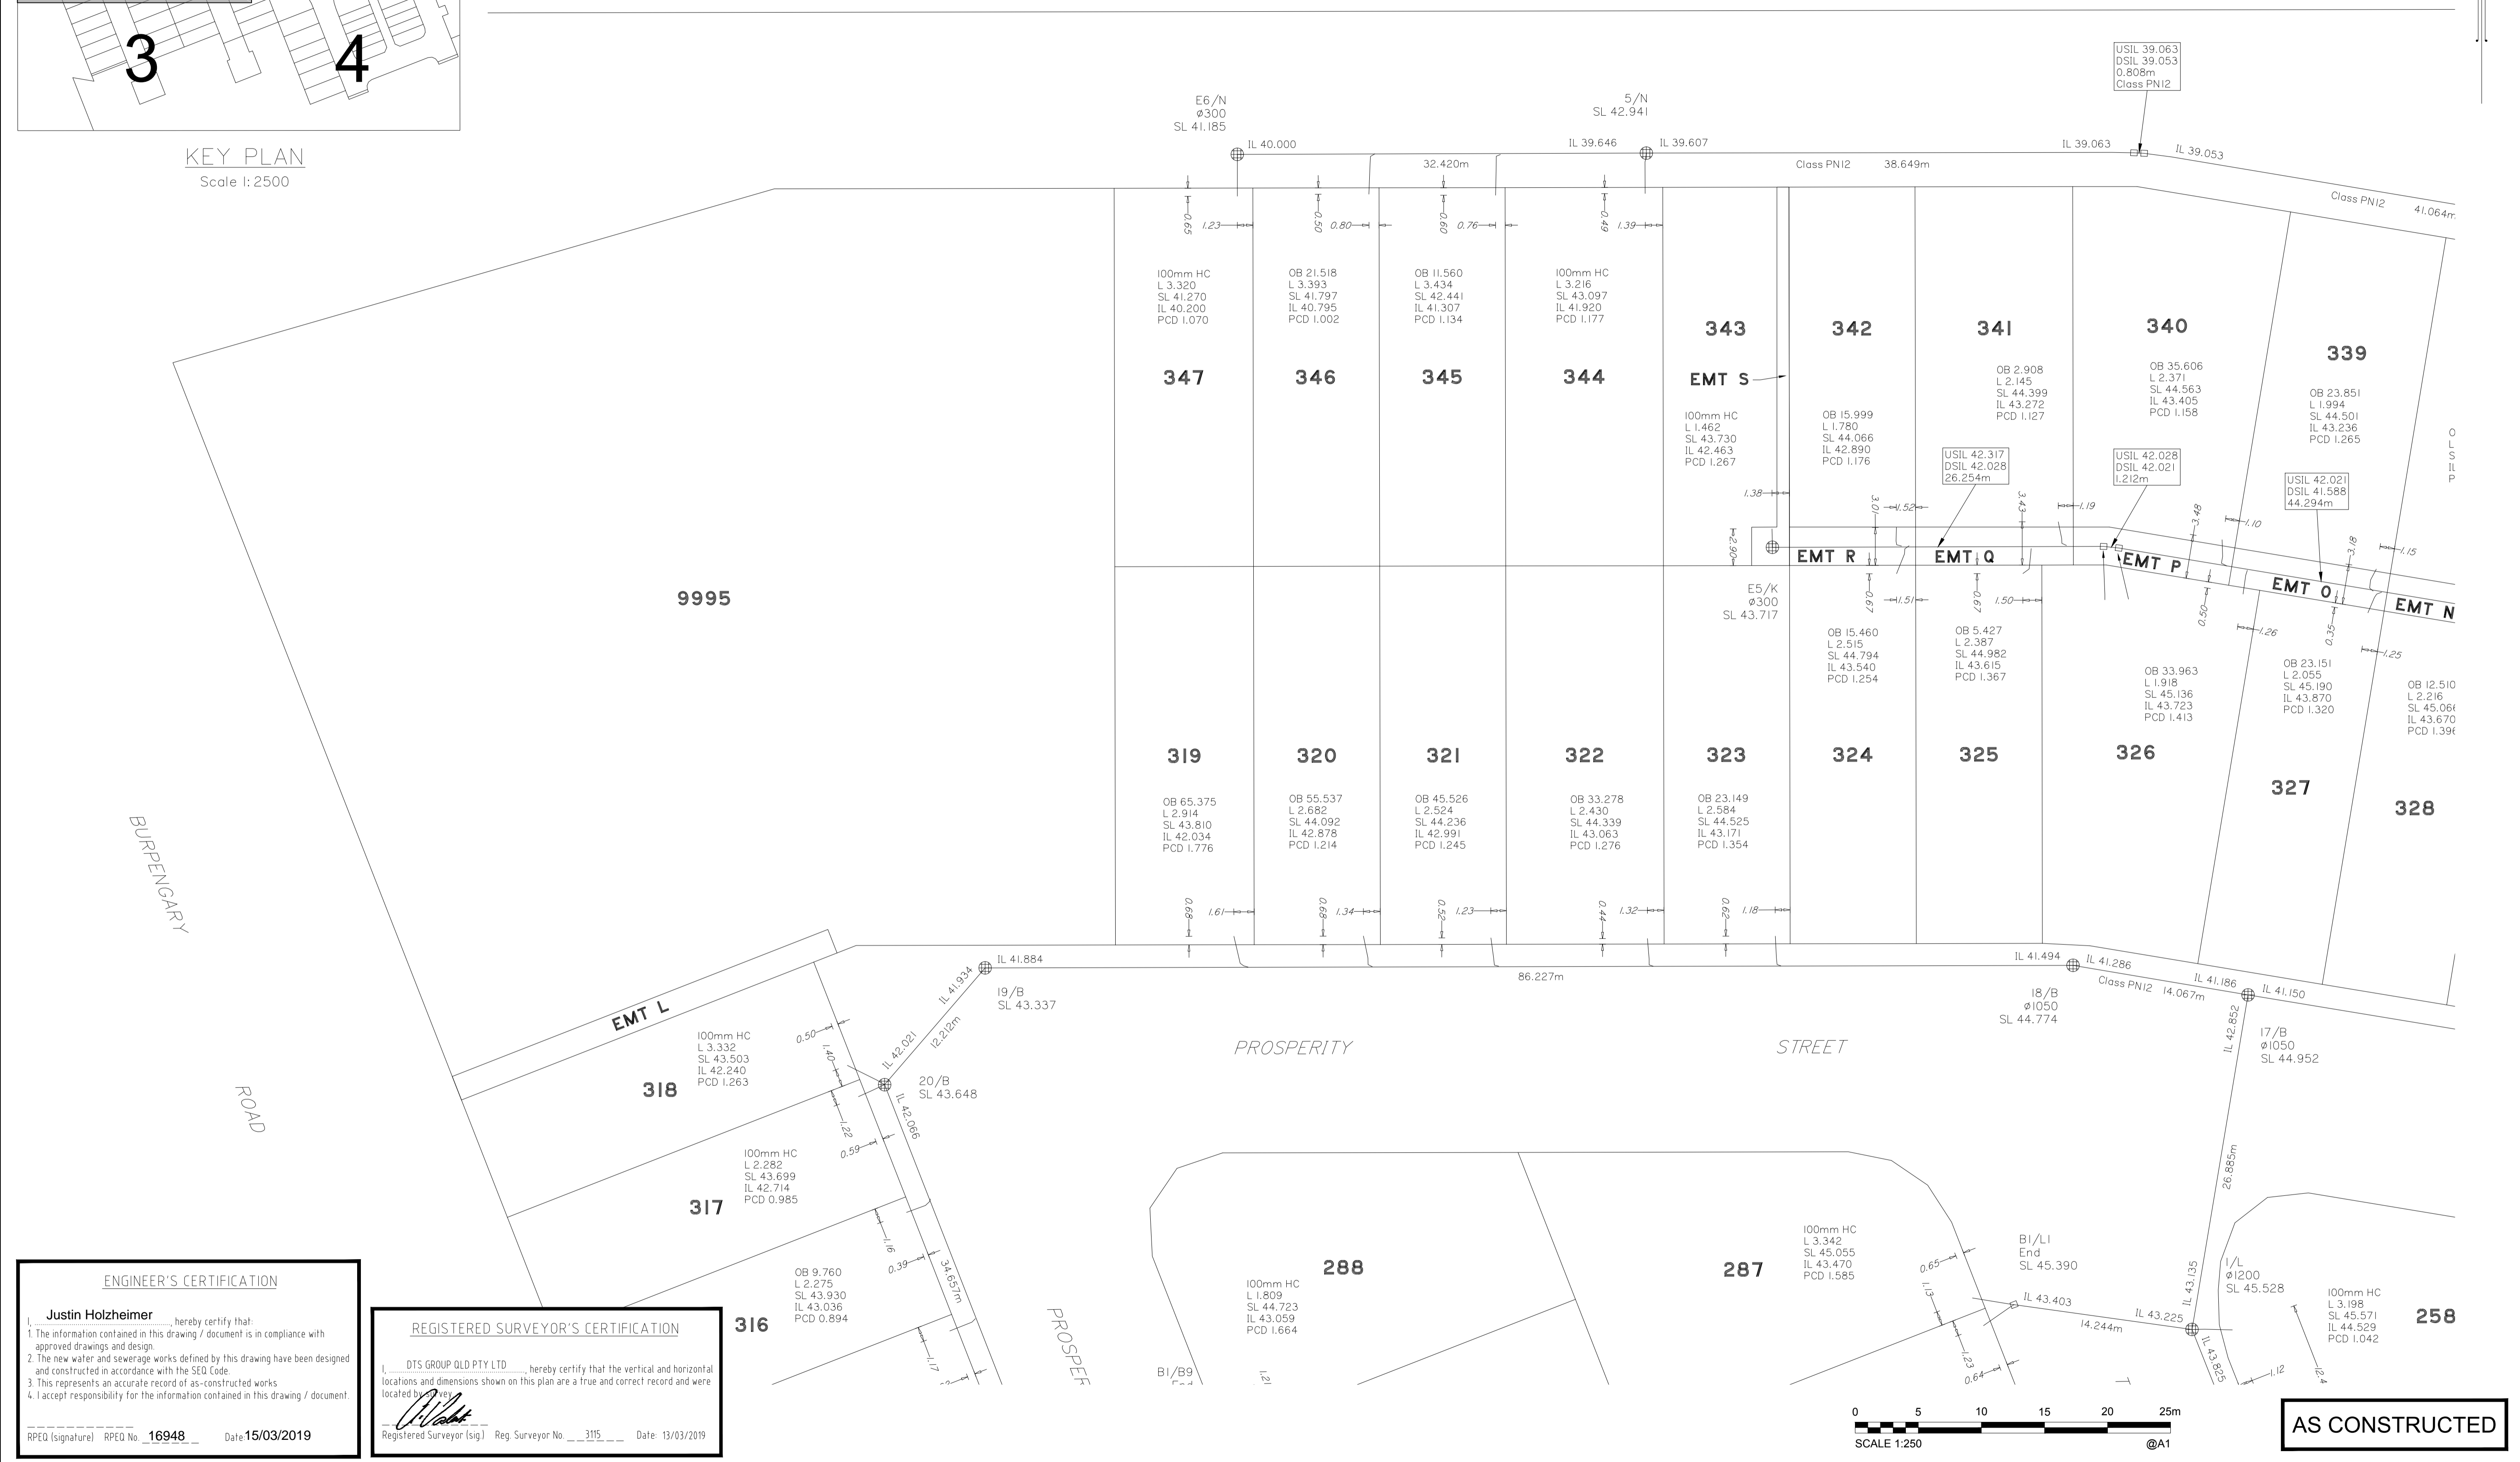

**ENGINEER'S CERTIFICATION**  
 Justin Holzheimer, hereby certify that:  
 1. The information contained in this drawing / document is in compliance with approved drawings and design.  
 2. The new water and sewerage works defined by this drawing have been designed and constructed in accordance with the SEQ Code.  
 3. This represents an accurate record of as-constructed works.  
 4. I accept responsibility for the information contained in this drawing / document.  
 RPED (signature) RPED No. 16948 Date 15/03/2019

**REGISTERED SURVEYOR'S CERTIFICATION**  
 DTS GROUP QLD PTY LTD, hereby certify that the vertical and horizontal locations and dimensions shown on this plan are a true and correct record and were located by me.  
 Registered Surveyor (sig) Reg. Surveyor No. 3115 Date: 13/03/2019

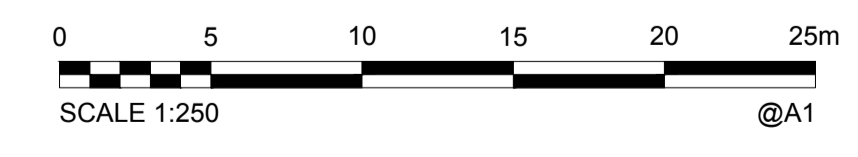

**AS CONSTRUCTED**

<b>A1</b>	INDEX	DATE	AS CONSTRUCTED - ORIGINAL ISSUE	REVISIONS	DRAWN	CHECKED	PASSED	INITIALS	DATE
	A	13/03/2019	AS CONSTRUCTED - ORIGINAL ISSUE		AA	JS	TL		

**dts** urban planning, surveying & development  
 Brisbane PO Box 3126, West End QLD 4101 Ph: 07 3118 8600  
 Mackay PO Box 11711, Mackay Queensland QLD 4740 Ph: 1300 276 783  
 mackay@dtsqld.com.au




**Unitywater**  
 AS CONSTRUCTED SEWER  
 AMITY NARANGBA - STAGES 3 & 10  
 BURPENGARY & CALLAGHAN ROADS, NARANGBA

SHEET 1 OF 8 SHEETS	SCALE 250
REVISION DATE 13/03/2019	REVISION A
DISCIPLINE CODE	
DRAWING NO. U-2018-0805	

**COORDINATE DATUM NOTE:**  
 HORIZONTAL COORDINATES (E, N) SUPPLIED ARE MAPPING GRID OF AUSTRALIA (MGA),  
 ZONE 56 BASED ON THE UNIVERSAL TRANSVERSE MERCATOR PROJECTION AND THE  
 GEOCENTRIC DATUM OF AUSTRALIA 1994.  
 HORIZONTAL DATUM DERIVED FROM PSM52870, E 496223.382, N 6992682.075.  
 LEVELS SUPPLIED ARE ON THE AUSTRALIAN HEIGHT DATUM (AHD)  
 LEVEL DATUM DERIVED FROM PSM52870 RL 4.4.140 (AHD)

PSM52870  
 E: 496223.382  
 N: 6992682.075  
 RL: 4.4.140m

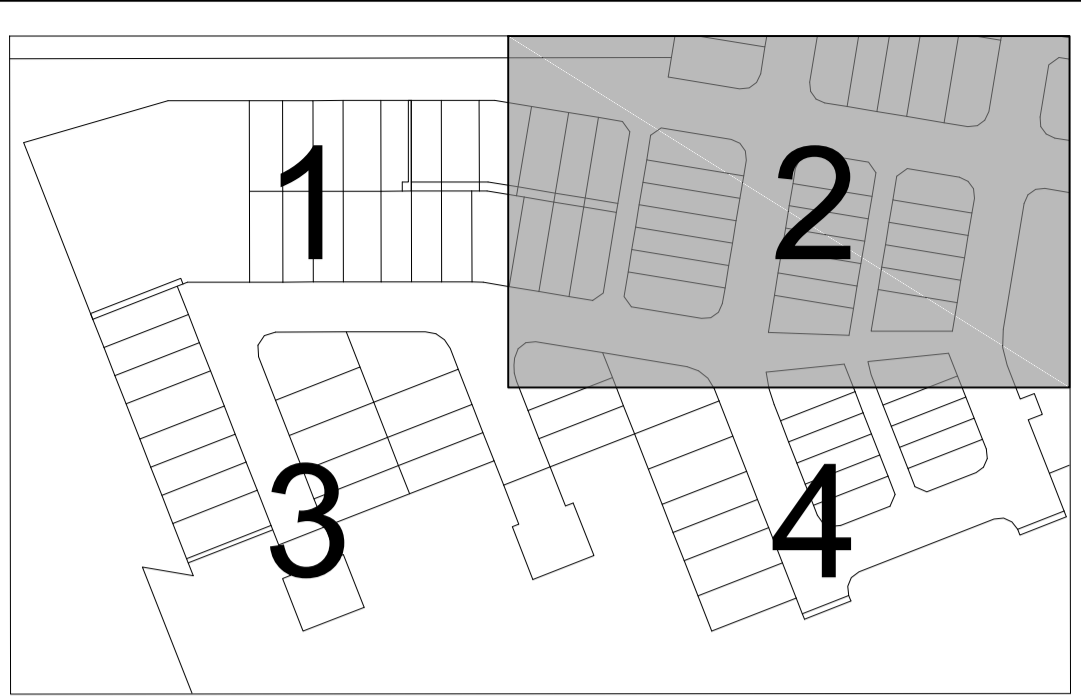

**KEY PLAN**  
 Scale 1:2500  
 Class PN12



**ENGINEER'S CERTIFICATION**  
 Justin Holzheimer, hereby certify that:  
 1. The information contained in this drawing / document is in compliance with approved drawings and design.  
 2. The new water and sewerage works defined by this drawing have been designed and constructed in accordance with the SEQ Code.  
 3. This represents an accurate record of as-constructed works.  
 4. I accept responsibility for the information contained in this drawing / document.  
 RPED (signature) RPED No. **16948** Date **15/03/2019**

**REGISTERED SURVEYOR'S CERTIFICATION**  
 I, **DTS GROUP QLD PTY LTD**, hereby certify that the vertical and horizontal locations and dimensions shown on this plan are a true and correct record and were located by me.  
 Registered Surveyor (sig) Reg Surveyor No. **3115** Date: **13/03/2019**

**AS CONSTRUCTED**


<b>A1</b>	INDEX	DATE	REVISIONS	DRAWN	CHECKED	PASSED	INITIALS	DATE
	A	13/03/2019	AS CONSTRUCTED - ORIGINAL ISSUE	AA	JS	TL		

**dts** urban planning, surveying & development  
 Brisbane PO Box 3128, West End QLD 4101 Ph: 07 3118 8600  
 Mackay PO Box 11711, Mackay Queensland QLD 4740 Ph: 1300 276 783  
 RPED (signature) RPED No. **16948** Date **15/03/2019**



**Unitywater**  
 AS CONSTRUCTED SEWER  
 AMITY NARANGBA - STAGES 3 & 10  
 BURPENGARY & CALLAGHAN ROADS, NARANGBA


SHEET 2 OF 8 SHEETS	SCALE 250
REVISION DATE 13/03/2019	REVISION <b>A</b>
DISCIPLINE CODE	
DRAWING NO. <b>U-2018-0805</b>	

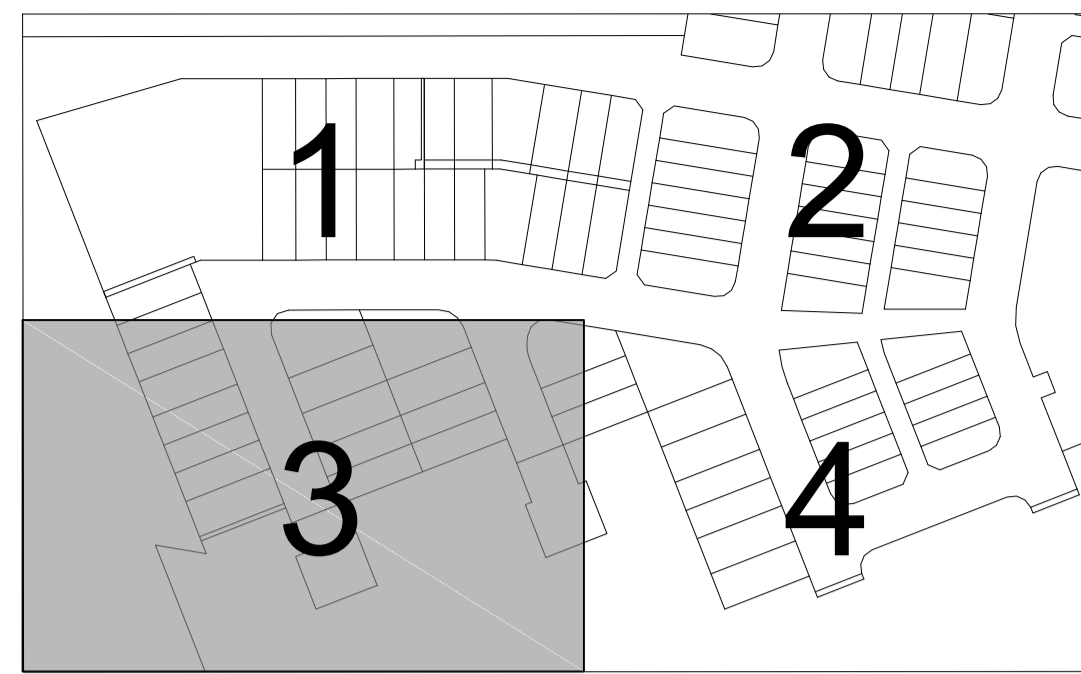

KEY PLAN  
Scale 1:2500




PSM52870  
E: 496223.382  
N: 6992682.075  
RL: 4.4.14.0m

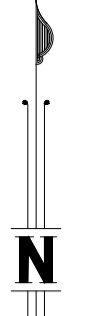

**ENGINEER'S CERTIFICATION**  
I, Justin Holzheimer, hereby certify that:  
1. The information contained in this drawing / document is in compliance with approved drawings and design.  
2. The new water and sewerage works defined by this drawing have been designed and constructed in accordance with the SEQ Code.  
3. This represents an accurate record of as-constructed works.  
4. I accept responsibility for the information contained in this drawing / document.  
RPED (signature) RPED No. 16948 Date: 15/03/2019

**REGISTERED SURVEYOR'S CERTIFICATION**  
I, DTS GROUP QLD PTY LTD, hereby certify that the vertical and horizontal locations and dimensions shown on this plan are a true and correct record and were located by me.  
*[Signature]*  
Registered Surveyor (sig) Reg Surveyor No. 3115 Date: 13/03/2019

**COORDINATE DATUM NOTE:**  
HORIZONTAL COORDINATES(E,N) SUPPLIED ARE MAPPING GRID OF AUSTRALIA(MGA), ZONE 56 BASED ON THE UNIVERSAL TRANSVERSE MERCATOR PROJECTION AND THE GEOCENTRIC DATUM OF AUSTRALIA 1994.  
HORIZONTAL DATUM DERIVED FROM PSM52870, E 496223.382, N 6992682.075.  
LEVELS SUPPLIED ARE ON THE AUSTRALIAN HEIGHT DATUM(AHD).  
LEVEL DATUM DERIVED FROM PSM52870 RL 4.4.14.0 (AHD)

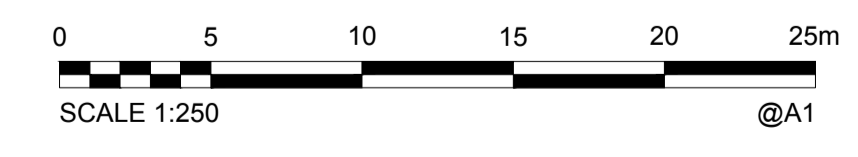

**AS CONSTRUCTED**

<b>A1</b>	INDEX	DATE	AS CONSTRUCTED - ORIGINAL ISSUE	DRAWN	CHECKED	PASSED	INITIALS	DATE
	A	13/03/2019	AS CONSTRUCTED - ORIGINAL ISSUE	AA	JS	TL		13/03/2019


**dts** urban planning, surveying & development  
Brisbane PO Box 3128, West End QLD 4101 Ph: 07 3118 0600  
Mackay PO Box 11711, Mackay Central QLD 4740 Ph: 08 206 7833  
Unitywater



**Unitywater**  
AS CONSTRUCTED SEWER  
AMITY NARANGBA - STAGES 3 & 10  
BURPENGARY & CALLAGHAN ROADS, NARANGBA



SHEET 3 OF 8 SHEETS	SCALE 250
REVISION DATE 13/03/2019	REVISION A
DISCIPLINE CODE	
DRAWING NO. U-2018-0805	

PSM52870  
 E: 496223.382  
 N: 6992682.075  
 RL: 4.4.14.0m

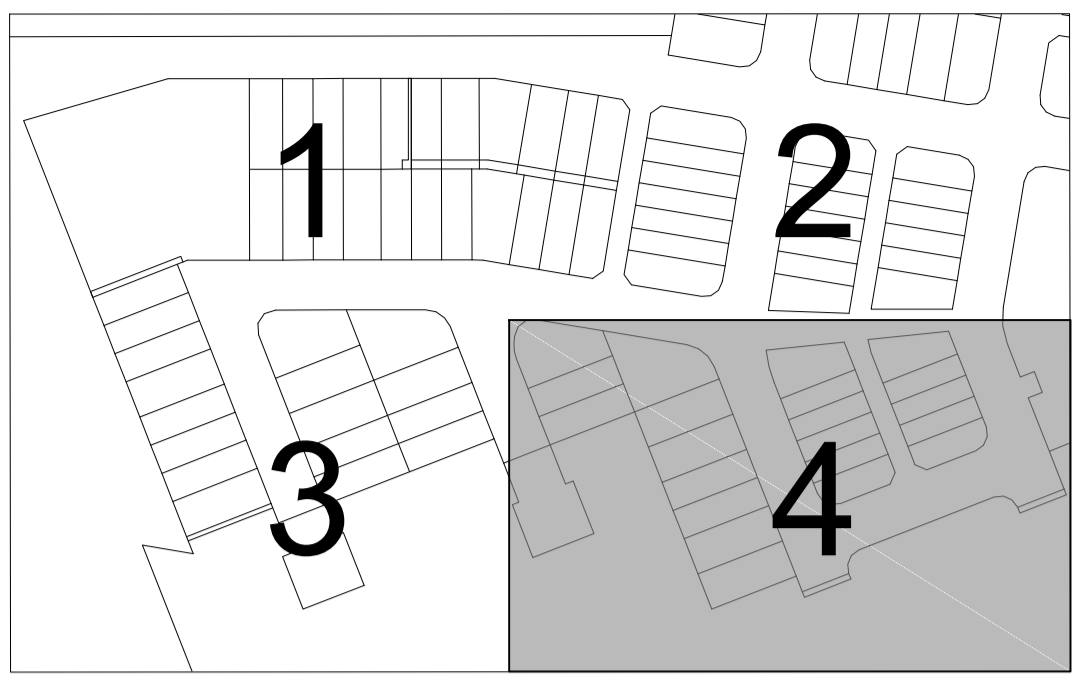

**KEY PLAN**

Scale 1: 2500

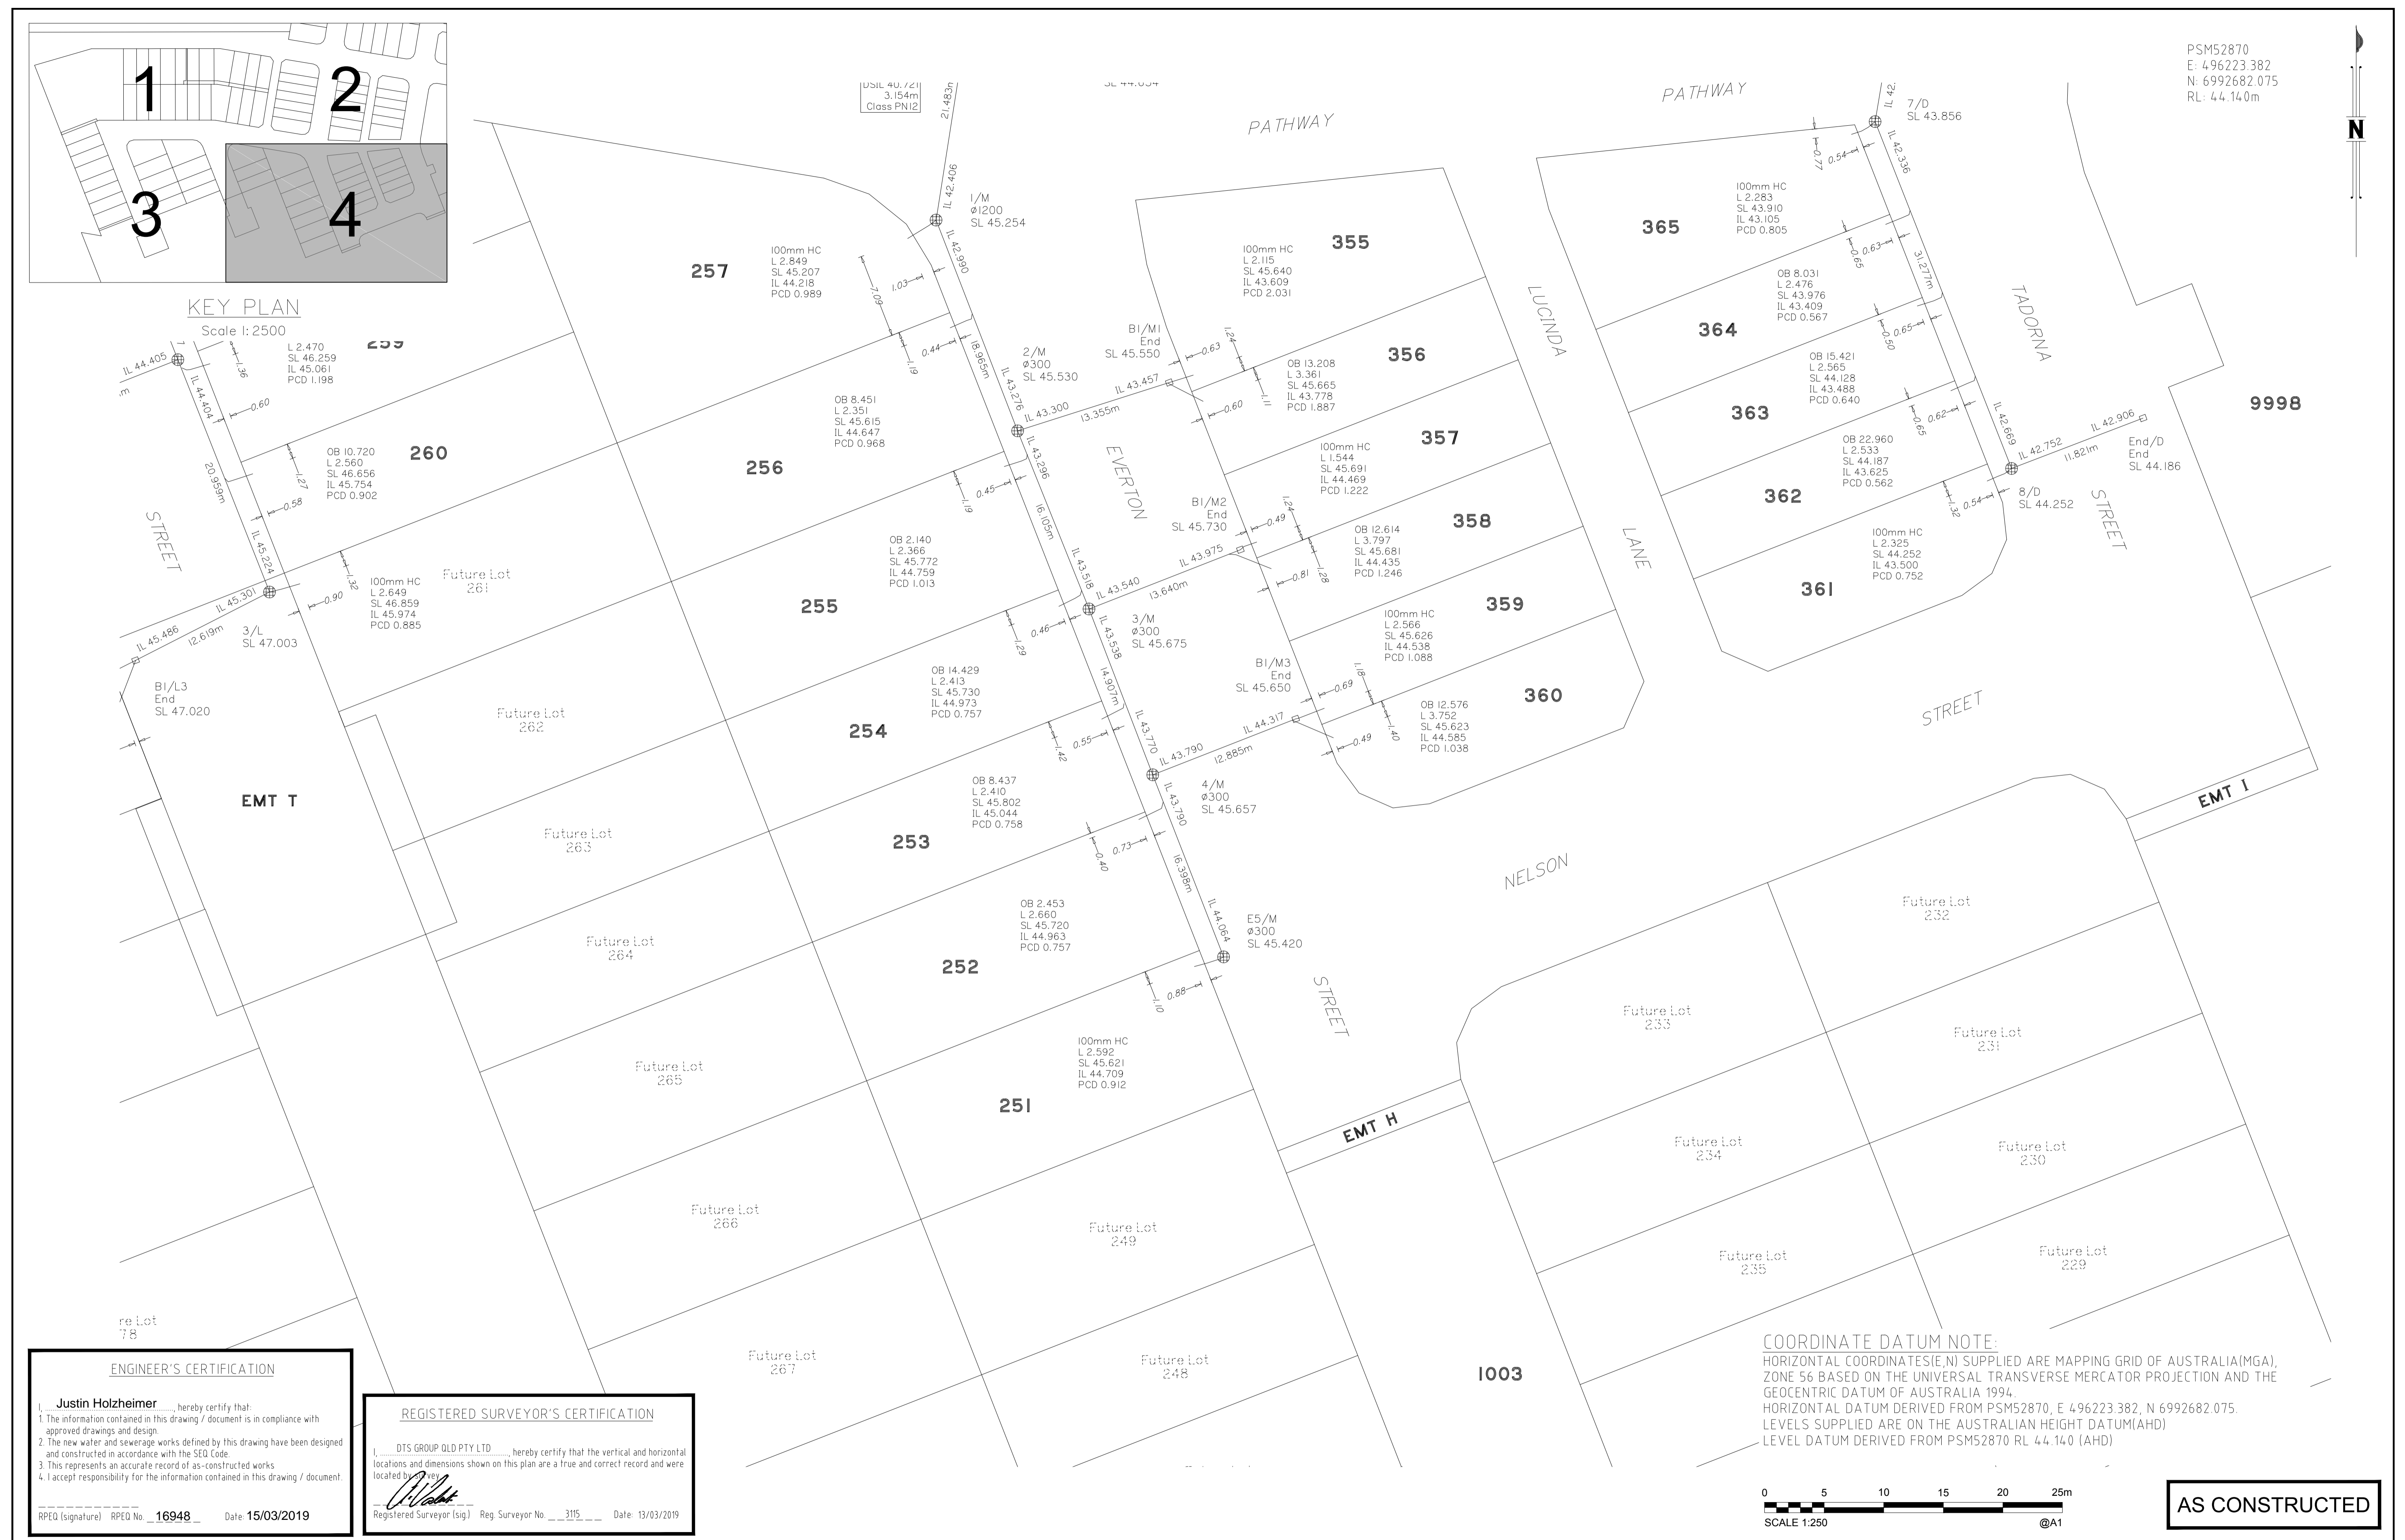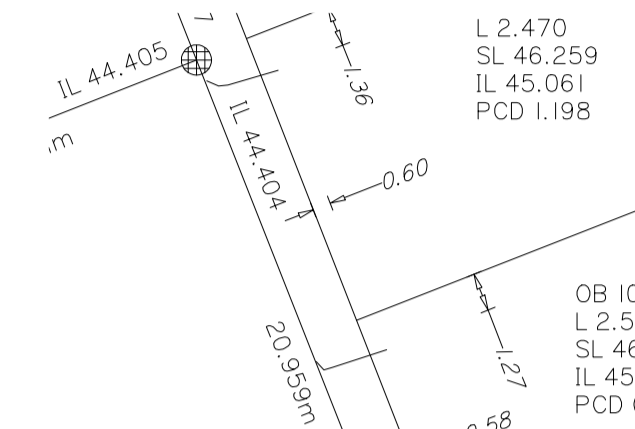

**ENGINEER'S CERTIFICATION**

I, Justin Holzheimer, hereby certify that:  
 1. The information contained in this drawing / document is in compliance with approved drawings and design.  
 2. The new water and sewerage works defined by this drawing have been designed and constructed in accordance with the SEQ Code.  
 3. This represents an accurate record of as-constructed works.  
 4. I accept responsibility for the information contained in this drawing / document.


RPED (signature) RPED No. 16948 Date: 15/03/2019

**REGISTERED SURVEYOR'S CERTIFICATION**

I, DTS GROUP QLD PTY LTD, hereby certify that the vertical and horizontal locations and dimensions shown on this plan are a true and correct record and were located by me.

[Signature]  
 Registered Surveyor (sig) Reg. Surveyor No. 3115 Date: 13/03/2019

**COORDINATE DATUM NOTE:**  
 HORIZONTAL COORDINATES(E,N) SUPPLIED ARE MAPPING GRID OF AUSTRALIA(MGA), ZONE 56 BASED ON THE UNIVERSAL TRANSVERSE MERCATOR PROJECTION AND THE GEOCENTRIC DATUM OF AUSTRALIA 1994.  
 HORIZONTAL DATUM DERIVED FROM PSM52870, E 496223.382, N 6992682.075.  
 LEVELS SUPPLIED ARE ON THE AUSTRALIAN HEIGHT DATUM(AHD).  
 LEVEL DATUM DERIVED FROM PSM52870 RL 4.4.14.0 (AHD)

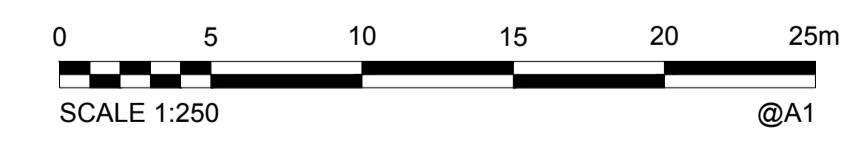

**AS CONSTRUCTED**

<b>A1</b>	INDEX	DATE	AS CONSTRUCTED - ORIGINAL ISSUE	REVISIONS	DRAWN	CHECKED	PASSED	INITIALS	DATE
	A	13/03/2019	AS CONSTRUCTED - ORIGINAL ISSUE		AA	JS	TL		

**dts** urban planning, surveying & development

Brisbane PO Box 3128, West End QLD 4101 Ph: 07 318 8600 brisbane@dtsqld.com.au

Mackay PO Box 11711, Mackay Central QLD 4740 Ph: 08 400 276 783 mackay@dtsqld.com.au



**Unitywater**

AS CONSTRUCTED SEWER  
 AMITY NARANGBA - STAGES 3 & 10  
 BURPENGARY & CALLAGHAN ROADS, NARANGBA

SHEET 4 OF 8 SHEETS	SCALE 250
REVISION DATE 13/03/2019	REVISION A
DISCIPLINE CODE	
DRAWING NO. U-2018-0805	