

REGISTERED SURVEYOR'S CERTIFICATION

DTS Group QLD Pty Ltd hereby certify that the vertical and horizontal locations and dimensions shown on this plan are a true and correct record and were located by survey.

[Signature]
Registered Surveyor (sig.)

Reg. Surveyor No. 3115 Date: 25/02/2021

Consulting Engineer's Certification:

I, Justin Holzheimer, being a certified/registered engineer and duly authorised representative of RMA Engineers hereby:

- Certify the information in this drawing is an accurate "as constructed" representation of the works.
- Accept responsibility for the "as constructed" information contained in this drawing.
- Acknowledge the "as constructed" information contained in the drawing may be relied on by Council and others.

Certification for Stage 8A by.....
on 25/02/2021 for RMA Engineers

RPEQ: I6948



urban planning, surveying & development


Brisbane

PO Box 3128 West End QLD 4101
Ph: 07 3118 0600
brisbane@dtsgld.com.au

Mackay

PO Box 11711, Mackay Caneland QLD 4740
Ph: 1300 278 783
mackay@dtsgld.com.au

Notes:

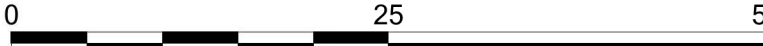

Scale 1:500 when plotted at A3

02550

Title Block 09-10-18

Real Property Description

Lots 206-213, 221-250, 1004 & 1005
on SP288955

Locality Narangba

Datum for Levels PM52870 RL44.14 AHD


| | | | | |
|---|-------------|-------------|-------------------|--------------------|
| BNE150725 Stage 8a Set out and Ascon.mpl Magnet File | L Book - | Drawn RC | Scale 1:500@A3 | Date 24/02/2021 |
|---|-------------|-------------|-------------------|--------------------|

Client: Dahua Pointcorp Narangba Pty Ltd

Contour and Asconstructed Survey

Amity Stage 8a
Callaghan Road
Narangba

| | | | |
|----------------|--------------------------|--------------------------------|----------|
| Surveyor RC | Project No. BNE150725 | Drawing No. S11051-A3 Sht 2 | Rev 0 |
|----------------|--------------------------|--------------------------------|----------|

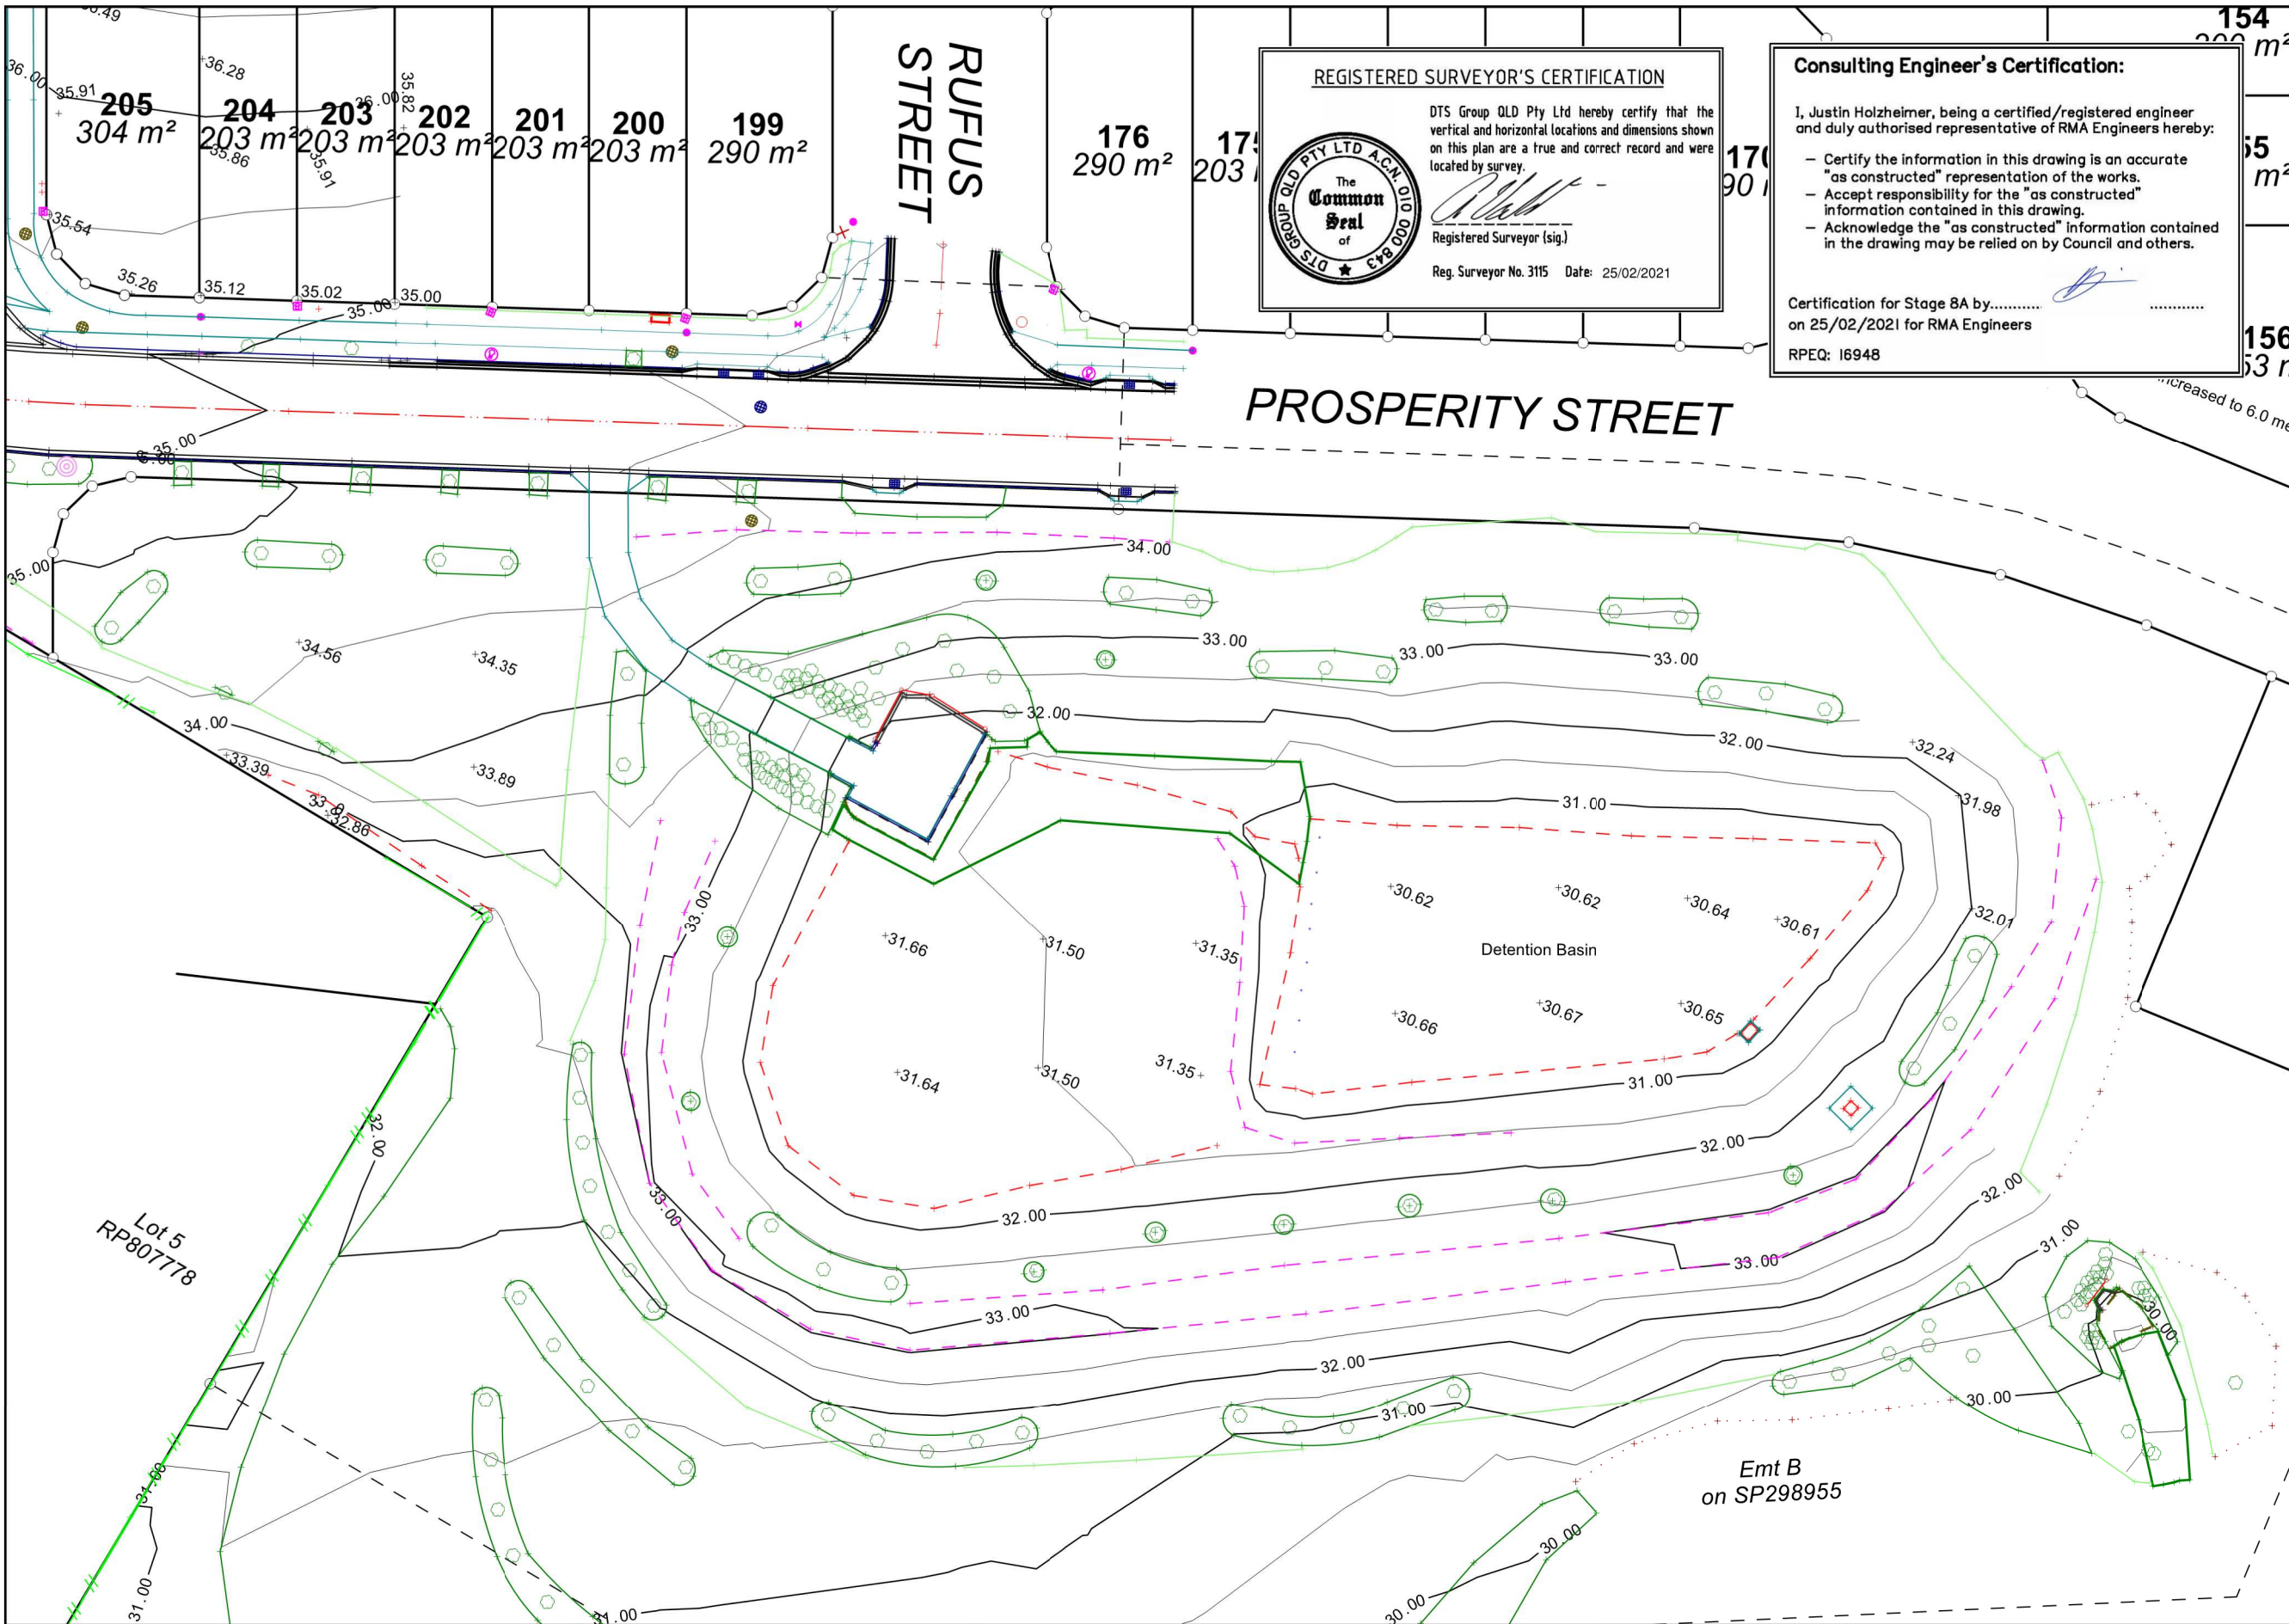

REGISTERED SURVEYOR'S CERTIFICATION

DTS Group QLD Pty Ltd hereby certify that the vertical and horizontal locations and dimensions shown on this plan are a true and correct record and were located by survey.

[Signature]
Registered Surveyor (sig.)
Reg. Surveyor No. 3115 Date: 25/02/2021

Consulting Engineer's Certification:

I, Justin Holzheimer, being a certified/registered engineer and duly authorised representative of RMA Engineers hereby:

- Certify the information in this drawing is an accurate "as constructed" representation of the works.
- Accept responsibility for the "as constructed" information contained in this drawing.
- Acknowledge the "as constructed" information contained in the drawing may be relied on by Council and others.

Certification for Stage 8A by.....
on 25/02/2021 for RMA Engineers
RPEQ: I6948

| Rev | Amendment | Date |
|-----|-----------|------|
| | | |
| | | |
| | | |

Field Shot Taken Here

Typical Box Kerb

Typical Traffic Island Kerb

TOG=Top of Gutter
RR=Roof Ridge

Typical Mountable Kerb

Legend

- Electricity Box
- Elect. Light Pole
- Electricity Pit
- Electricity Pole
- Fire Hydrant
- Gas
- Gully Pit (Backstone)
- Gully Pit (Centre of Grate)
- Inspection Opening
- Post
- Sewerage MH
- Stormwater MH
- Telstra Pit
- Tree
- Valve
- Water Meter

Edge of Concrete

Top of Bank

Bottom of Bank

Edge Of Bit.

Fence

Crown of Road

Garden Edge

TOW = Top of (Retaining) Wall

Urban planning, surveying & development

dtS

Brisbane

PO Box 3128 West End QLD 4101
Ph: 07 3118 0600
brisbane@dtsgld.com.au

Mackay

PO Box 11711, Mackay Caneland QLD 4740
Ph: 1300 278 783
mackay@dtsgld.com.au

Notes:

0 25 50

Scale 1:500 when plotted at A3

Title Block 09-10-18

Real Property Description

Lots 206-213, 221-250, 1004 & 1005
on SP288955

Locality Narangba

Datum for Levels PM52870 RL44.14 AHD

| L Book | Drawn | Scale | Date |
|--------|-------|----------|------------|
| - | RC | 1:500@A3 | 24/02/2021 |


BNE150725 Stage 8a
Set out and Ascon.mpl
Magnet File

Client: Dahua Pointcorp Narangba Pty Ltd

Contour and Asconstructed Survey

Amity Stage 8a
Callaghan Road
Narangba

| Surveyor | Project No. | Drawing No. | Rev |
|----------|-------------|----------------|-----|
| RC | BNE150725 | S11051-A3 Sht3 | 0 |

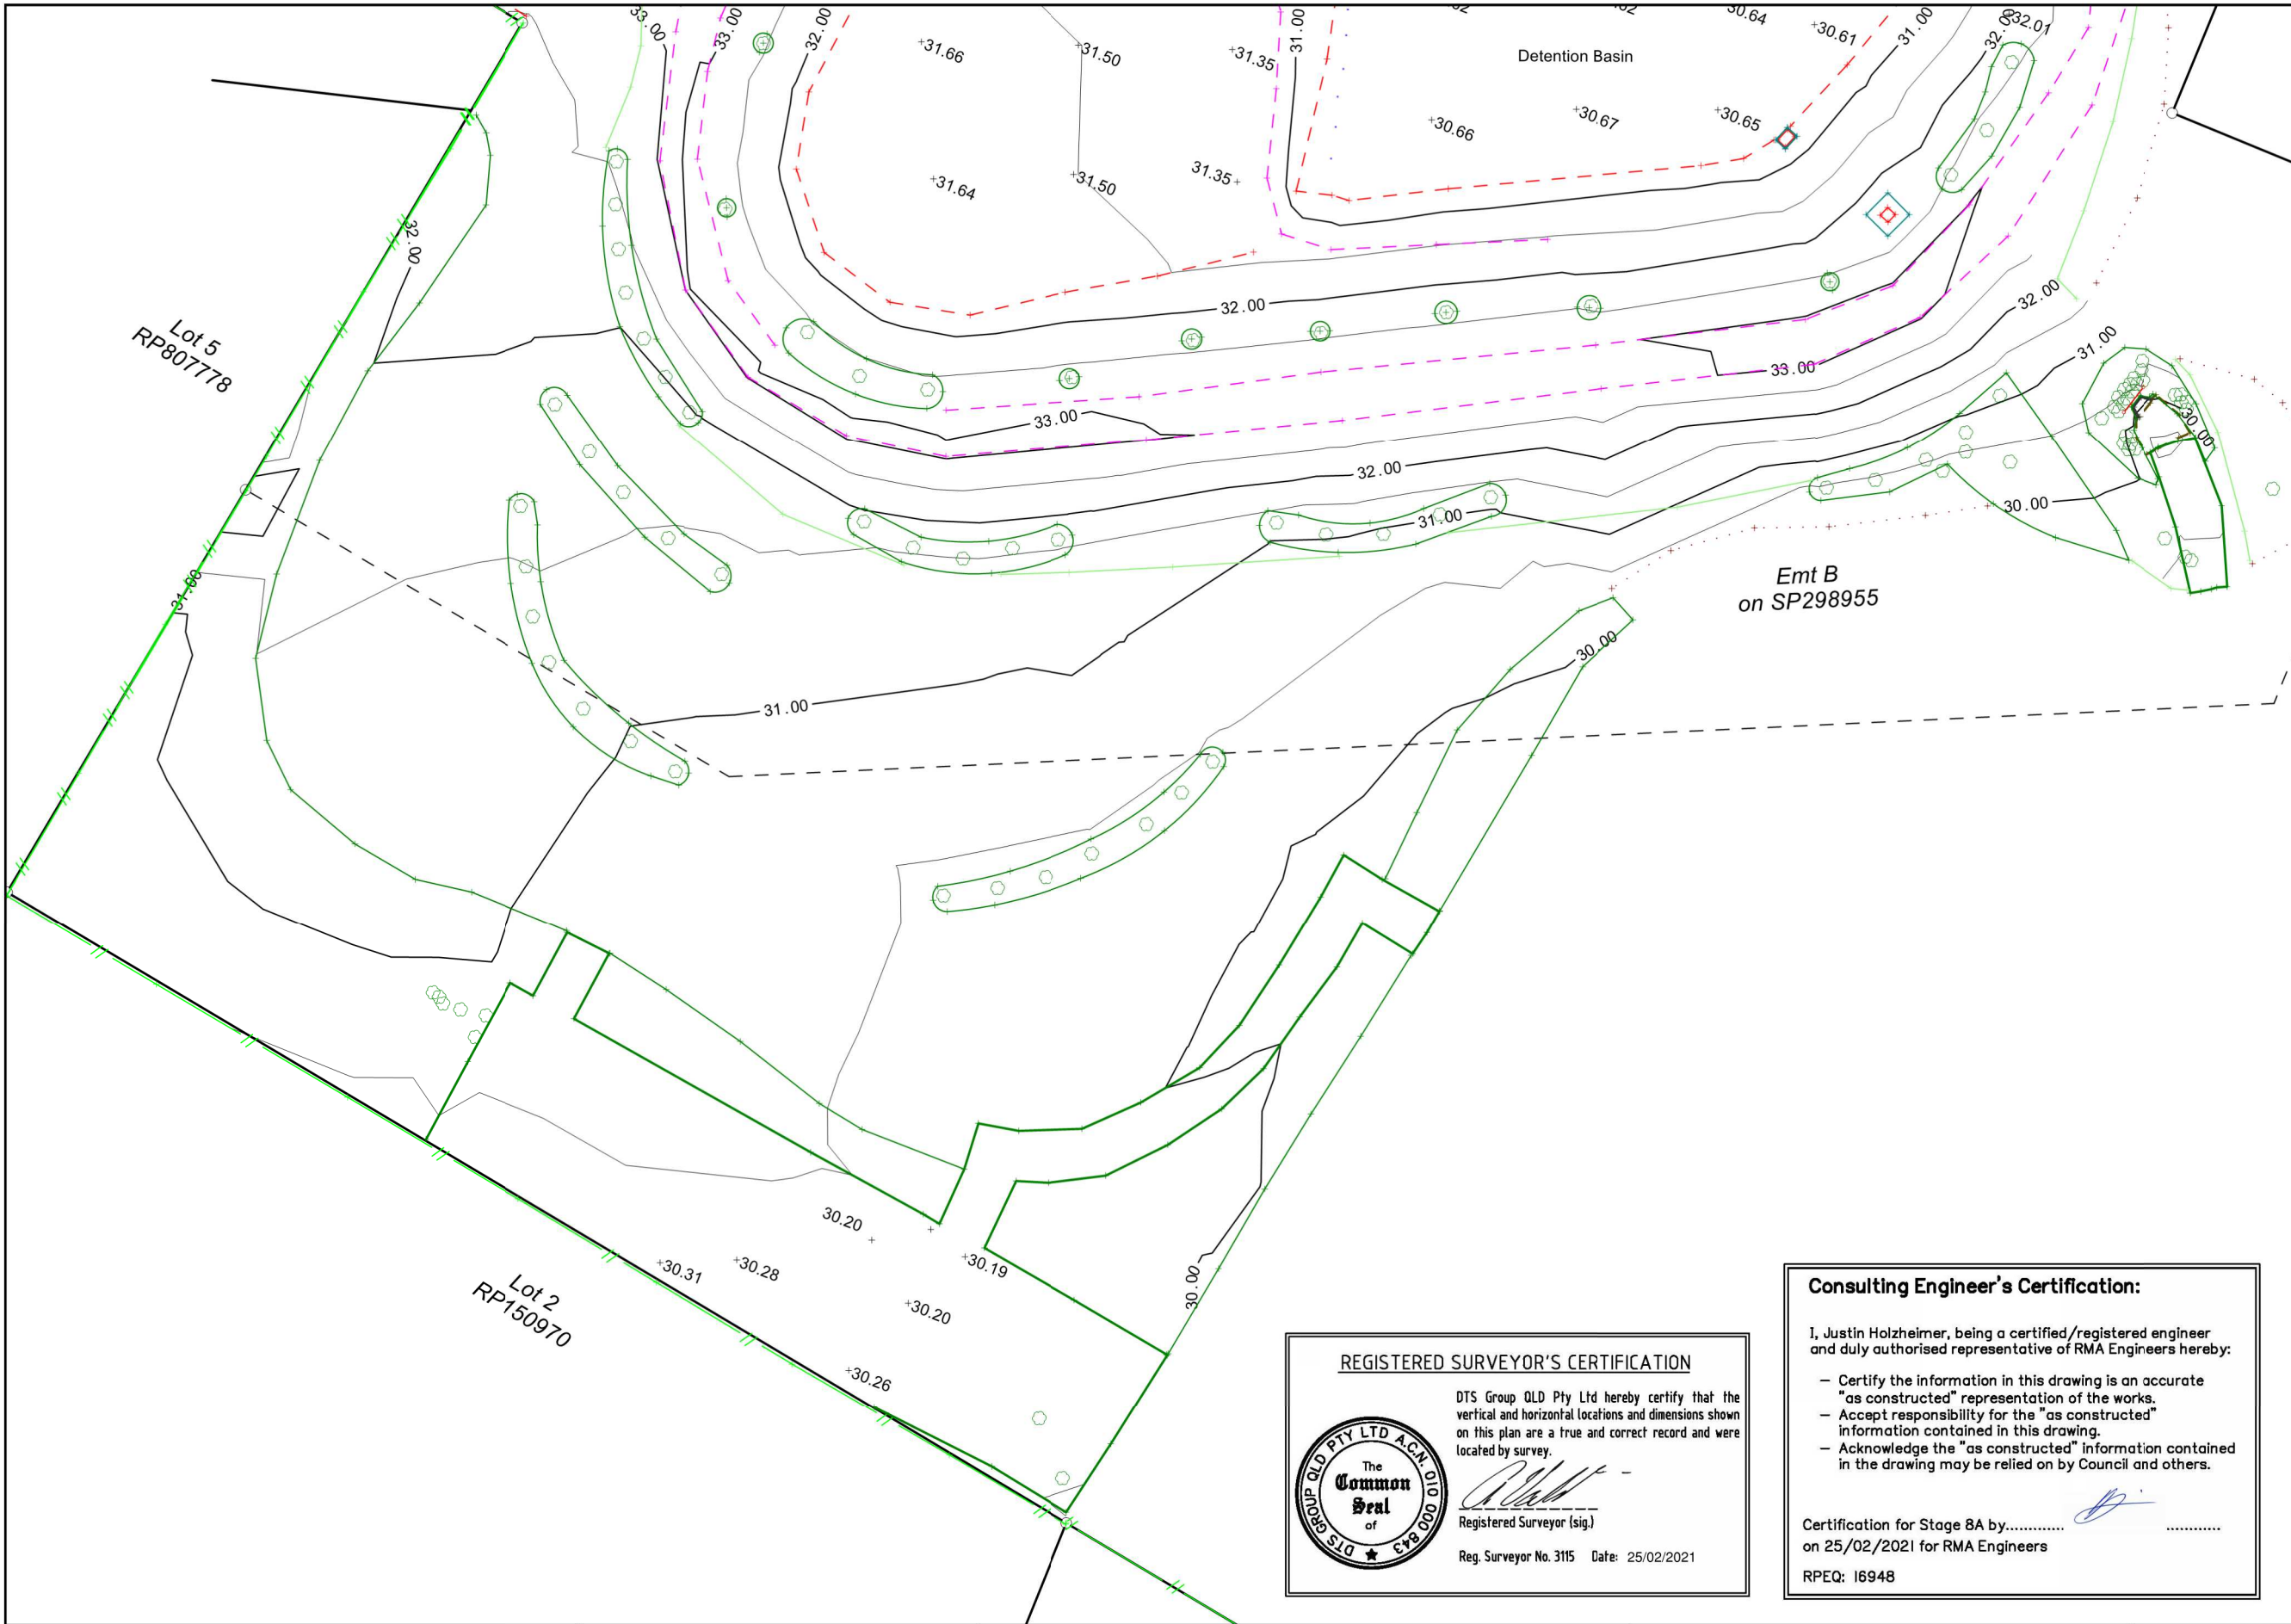

| Rev | Amendment | Date |
|-----|-----------|------|
| | | |
| | | |
| | | |

Typical Mountable Kerb

Legend

Electricity Box

Elect. Light Pole

Electricity Pit

Electricity Pole

Fire Hydrant

Gas

Gully Pit (Backstone)

Gully Pit (Centre of Grate)

Inspection Opening

Post

Sewerage MH

Stormwater MH

Telstra Pit

Tree

Valve

Water Meter

TOW = Top of (Retaining) Wall

REGISTERED SURVEYOR'S CERTIFICATION

DTS Group QLD Pty Ltd hereby certify that the vertical and horizontal locations and dimensions shown on this plan are a true and correct record and were located by survey.

Registered Surveyor (sig.)

Reg. Surveyor No. 3115 Date: 25/02/2021

Consulting Engineer's Certification:

I, Justin Holzheimer, being a certified/registered engineer and duly authorised representative of RMA Engineers hereby:

- Certify the information in this drawing is an accurate "as constructed" representation of the works.
- Accept responsibility for the "as constructed" information contained in this drawing.
- Acknowledge the "as constructed" information contained in the drawing may be relied on by Council and others.

Certification for Stage 8A by.....
on 25/02/2021 for RMA Engineers

RPEQ: 16948

Brisbane

PO Box 3128 West End QLD 4101
Ph: 07 3118 0600
brisbane@dtsgld.com.au

Mackay

PO Box 11711, Mackay Caneland QLD 4740
Ph: 1300 278 783
mackay@dtsgld.com.au

Notes:

Scale 1:500 when plotted at A3

Title Block 09-10-18

Real Property Description

Lots 206-213, 221-250, 1004 & 1005
on SP288955

Locality Narangba

Datum for Levels PM52870 RL44.14 AHD

| | | | | |
|--|-------------|-------------|-------------------|--------------------|
| BNE150725 Stage 8a Set out and Ascon.mxd Magnet File | L Book - | Drawn RC | Scale 1:500@A3 | Date 24/02/2021 |
|--|-------------|-------------|-------------------|--------------------|

Client: Dahua Pointcorp Narangba Pty Ltd

Contour and Asconstructed Survey

Amity Stage 8a
Callaghan Road
Narangba

| | | | |
|----------------|--------------------------|-------------------------------|----------|
| Surveyor RC | Project No. BNE150725 | Drawing No. S11051-A3 Sht4 | Rev 0 |
|----------------|--------------------------|-------------------------------|----------|