

SYMBOLS

TREE CODES

FR Fruit Tree	NAT Native Tree	OR Ornamental Tree	PA Palm	PN Pine Tree	SH Shrub
---------------	-----------------	--------------------	---------	--------------	----------

TREE LEGEND

Type of Tree
Diameter @ 1.3m
Spread of Canopy 3.0m

ABBREVIATIONS


TOG Top of Gutter	FL Floor Level	RR Roof Ridge	IL Invert Level	SL Surface Level	Ø Diameter
RET Retaining Wall					

SURVEY LEGEND

Edge of Bitumen	Bottom of Bank
Retaining Wall	Crown of Road
Top of Bank	Change of Grade
Fence	Edge of Vegetation
Guard Rail	Overhead Elect
Overhead Comms	Overhead Unknown

SUBSURFACE UTILITY LEGEND (Quality Level C demonstrated below)

Comms	Electricity
Optic Fibre	Electric HV
Telstra	Elect LV
Fire Services	Petroleum
Gas	Recycled Water
Gas Low Press	Unknown
Gas High Press	Water
Drainage	Irrigation
Sewer	Rising Main

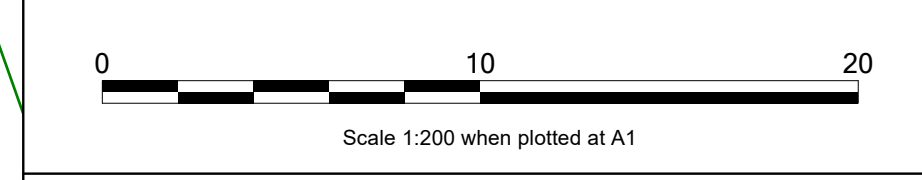

dts urban planning, surveying & development

PO Box 3128 West End QLD 4101
Ph: 07 3118 0000
brisbane@dtspld.com.au


Mackay
Ph: 1300 778 783
mackay@dtspld.com.au

ELECTROSCAN
UTILITY LOCATION, MAPPING AND PROTECTION

1071 3118 0000
electroscanpl.com.au

PO Box 3128, West End 4101
Level 2, 22 Conkella Street, South Brisbane, 4101

ELECTROSCAN IABN 27 010 000 843 | ACN 010 000 843

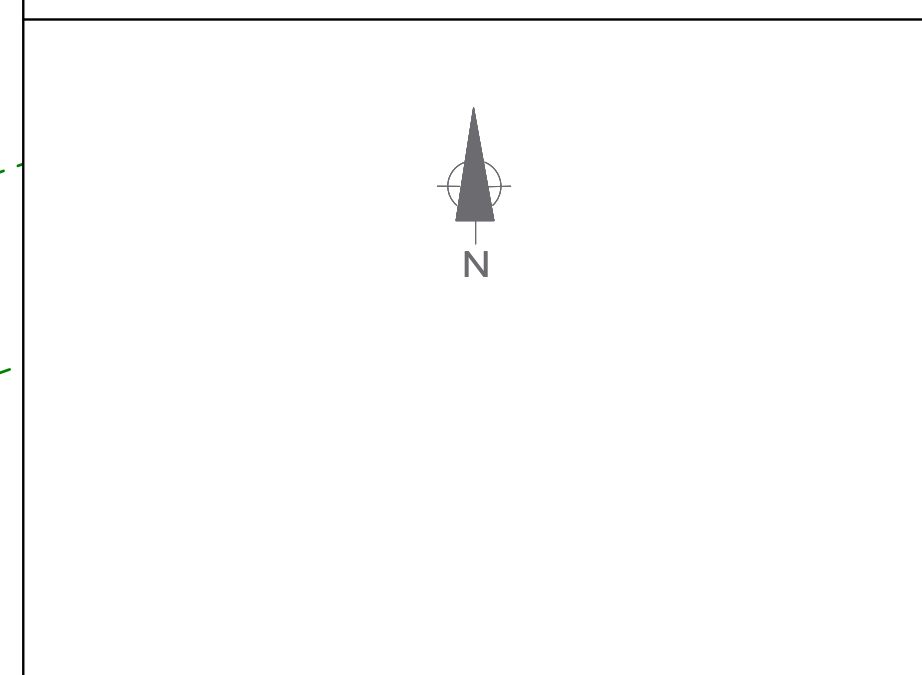

Revision	Description	Date
0	Original Issue	28/01/2022

Client: Dahua Pointcorp Narangba PTY LTD

As-Constructed Contour Survey
Callaghan Road, Narangba

Real Property Description
Lots 177-205, 214-220 and 1006 on SP317118
Locality: Narangba
Datum for Levels PM52870 RL44.14m AHD

Surveyor RG	Locator -	Drawn RG	Date 28/01/2022	Drawing No. S11453-A1 Sheet 1
Scale 1:200@A1	Magnet File BNE150725 Stage 8B Set out and Asson.mpl	Project No. BNE150725	Revision 0	

Consulting Engineer's Certification:

I, Justin Halzheimer, being a certified/registered engineer and duly authorised representative of RMA Engineers hereby:


- Certify the information in this drawing is an accurate "as constructed" representation of the works.
- Accept responsibility for the "as constructed" information contained in this drawing.
- Acknowledge the "as constructed" information contained in the drawing may be relied on by Council and others.

Certification for Stage 8B by.....
on 31/01/2022 for RMA Engineers
RPEQ: I6948

REGISTERED SURVEYOR'S CERTIFICATION

DTS Group OLD Pty Ltd hereby certify that the vertical and horizontal locations and dimensions shown on this plan are a true and correct record and were located by survey.

Registered Surveyor (sig.)
Reg. Surveyor No. 3115 Date: 31/01/2022

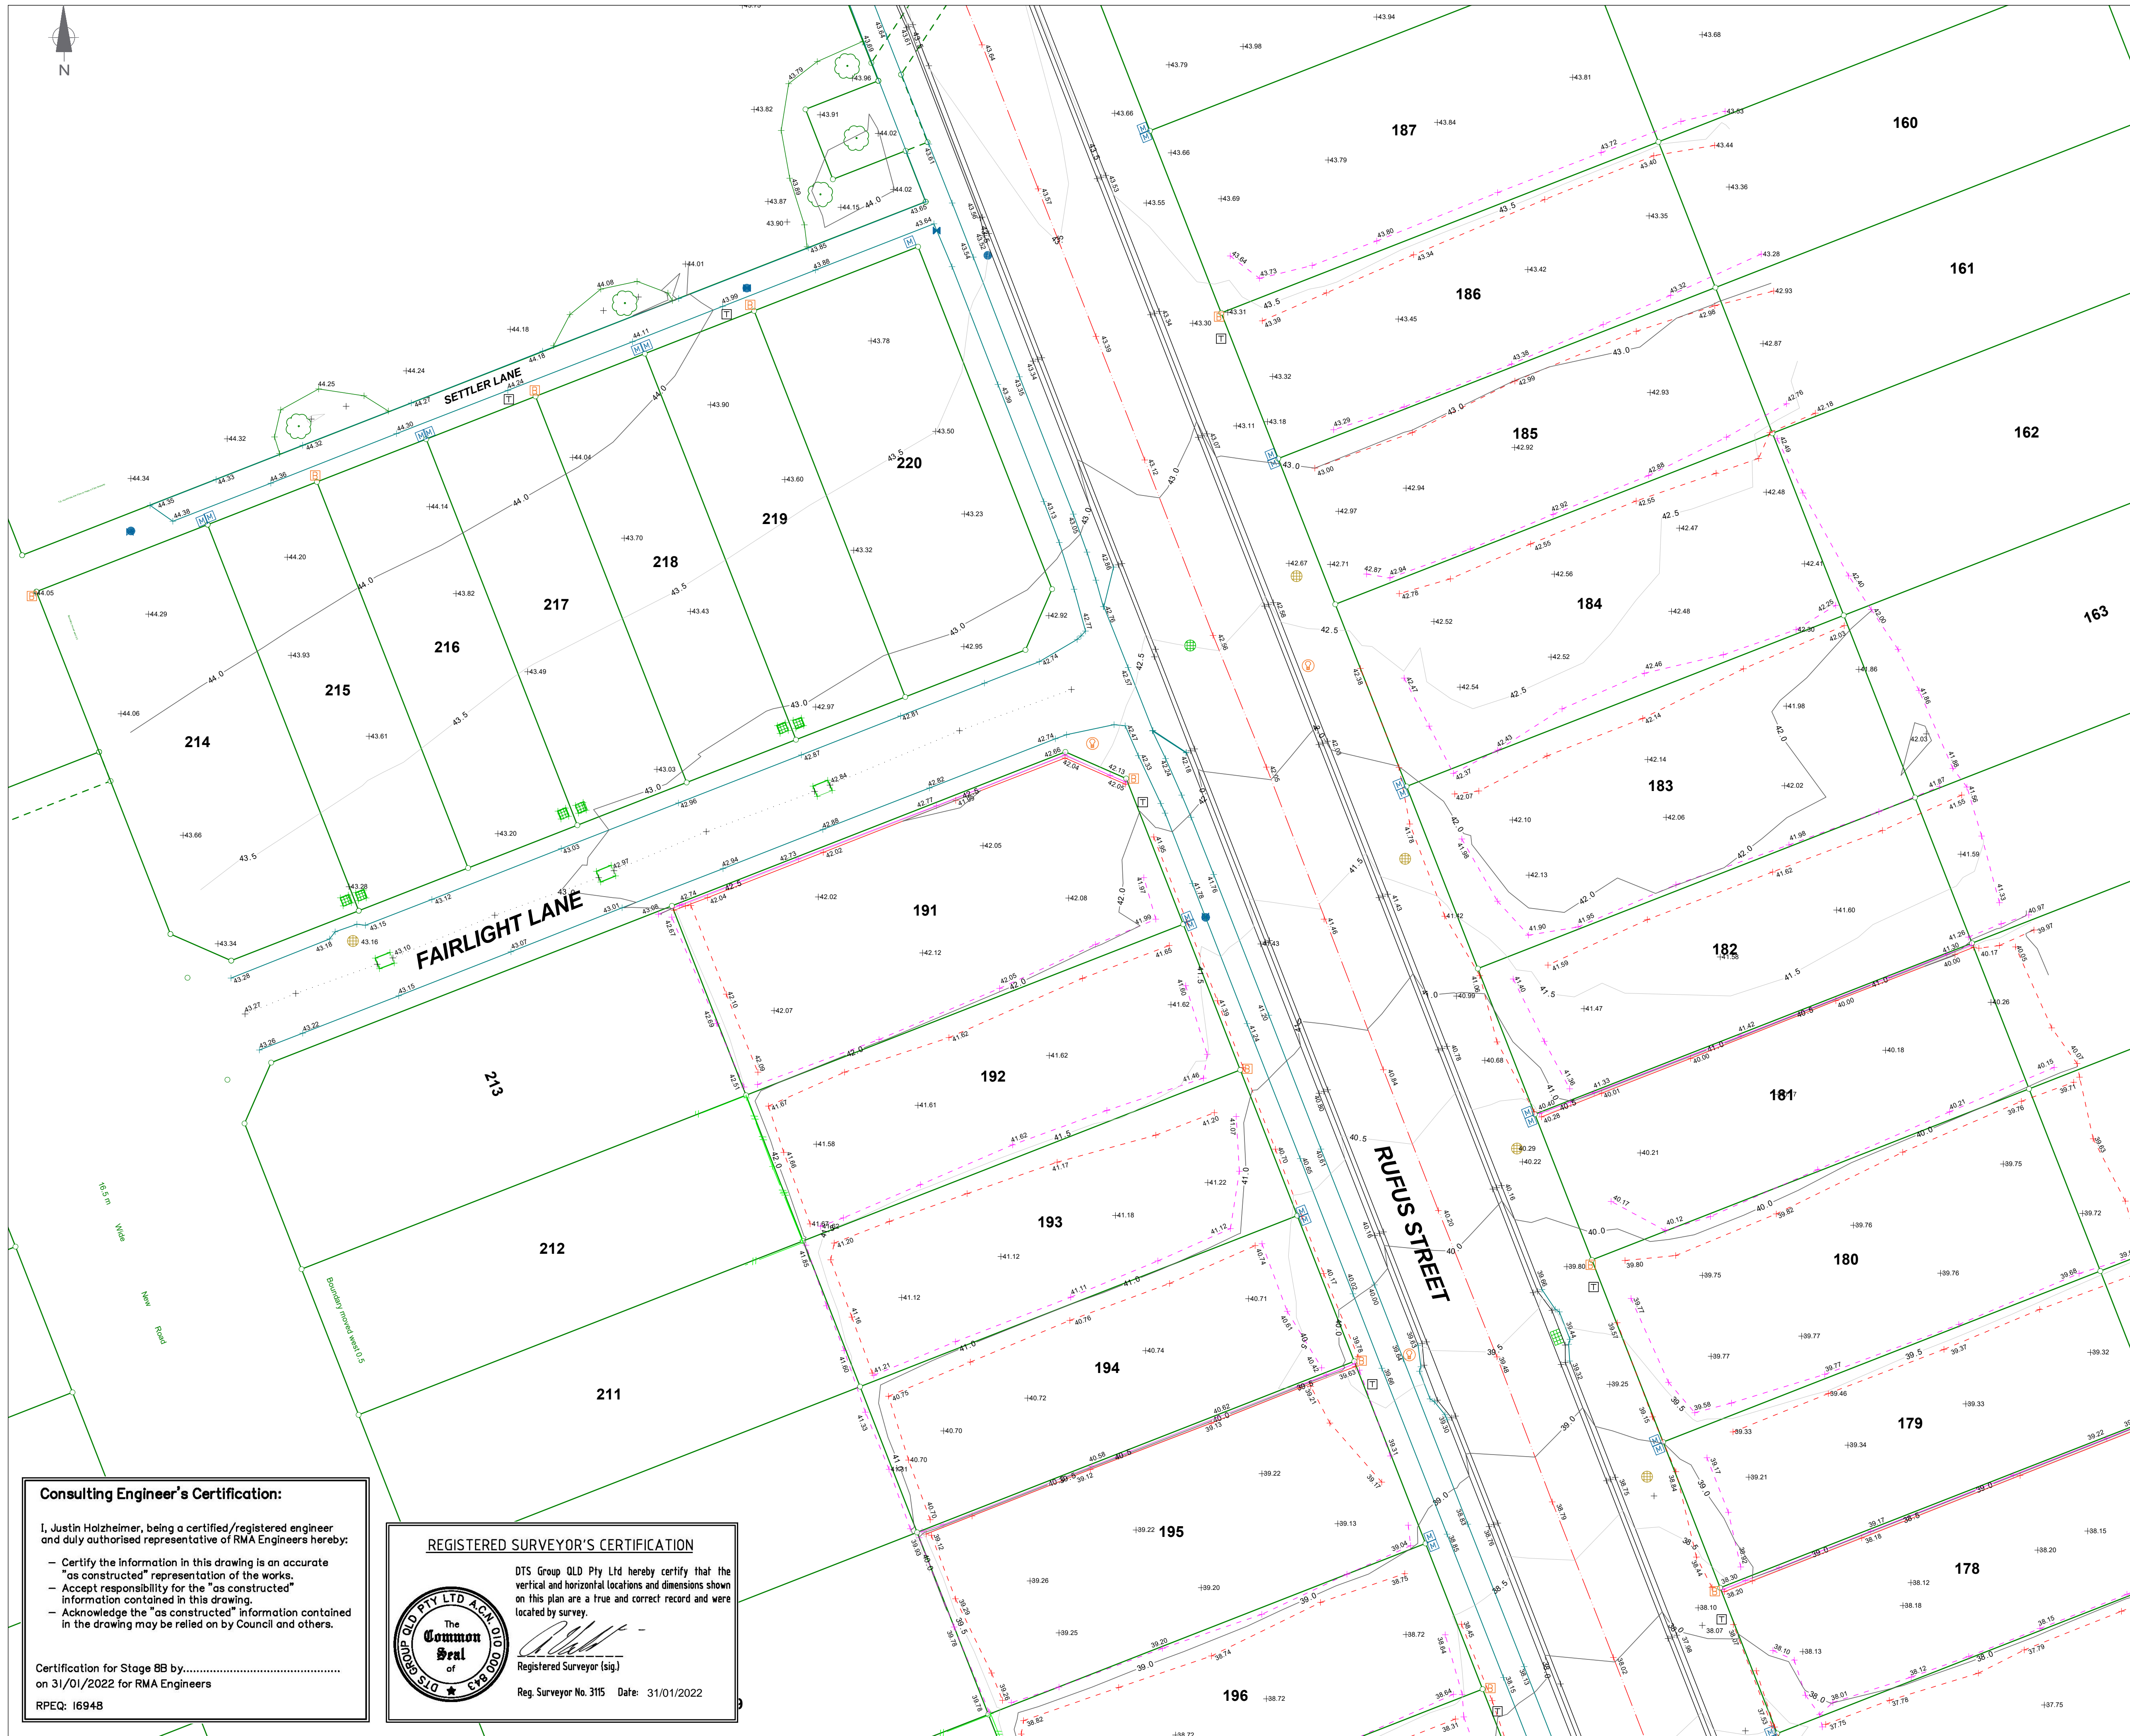

SYMBOLS

TREE CODES

FR Fruit Tree	NAT Native Tree	OR Ornamental Tree	PA Palm	PN Pine Tree	SH Shrub
---------------	-----------------	--------------------	---------	--------------	----------

TREE LEGEND

Type of Tree
Diameter @ 1.3m
Canopy 3.0m
VT-PA0203

ABBREVIATIONS


TOG Top of Gutter	FL Floor Level	RR Roof Ridge	IL Invert Level	SL Surface Level	Ø Diameter
RET Retaining Wall					

SURVEY LEGEND

Edge of Bitumen	Bottom of Bank
Retaining Wall	Crown of Road
Top of Bank	Change of Grade
Fence	Edge of Vegetation
Guard Rail	Overhead Elect
Overhead Comms	Overhead Unknown

SUBSURFACE UTILITY LEGEND (Quality Level C demonstrated below)

Comms	Electricity
Optic Fibre	Electric HV
Telstra	Elect LV
Fire Services	Petroleum
Gas	Recycled Water
Gas Low Press	Unknown
Gas High Press	Water
Drainage	Irrigation
Sewer	Rising Main

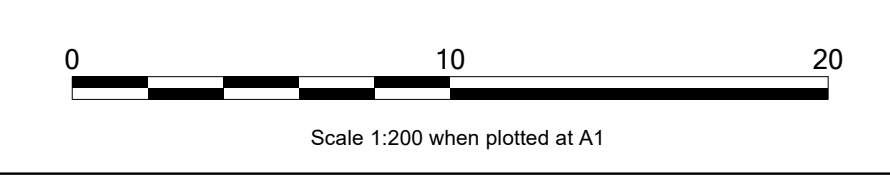

dts urban planning, surveying & development

PO Box 3128 West End QLD 4101
Ph: 07 3118 0000
brisbane@dtspld.com.au

Mackay
Ph: 1300 778 763
mackay@dtspld.com.au

ELECTROSCAN
UTILITY LOCATION, MAPPING AND PROTECTION

07 3118 0000
Electroscanqld.com.au

PO Box 3128, West End 4101
Level 2, 22 Conalla Street, South Brisbane, 4101

ELECTROSCAN IABN 27 010 000 843 | ACN 010 000 843

Consulting Engineer's Certification:

I, Justin Holzheimer, being a certified/registered engineer and duly authorised representative of RMA Engineers hereby:

- Certify the information in this drawing is an accurate "as constructed" representation of the works.
- Accept responsibility for the "as constructed" information contained in this drawing.
- Acknowledge the "as constructed" information contained in the drawing may be relied on by Council and others.

Certification for Stage 8B by.....
on 31/01/2022 for RMA Engineers
RPEQ: I6948

REGISTERED SURVEYOR'S CERTIFICATION

DTS Group QLD Pty Ltd hereby certify that the vertical and horizontal locations and dimensions shown on this plan are a true and correct record and were located by survey.

Registered Surveyor (sig.)
Reg. Surveyor No. 3115 Date: 31/01/2022

Revision	Description	Date
0	Original Issue	28/01/2022

Client: Dahua Pointcorp Narangba PTY LTD

As-Constructed Contour Survey
Callaghan Road, Narangba

Real Property Description
Lots 177-205, 214-220 and 1006 on SP317118
Locality: Narangba
Datum for Levels PMS2870 RL44.14m AHD

Surveyor RG	Locator -	Drawn RG	Date 28/01/2022	Drawing No. S11453-A1 Sheet 2
Scale 1:200@A1	Magnet File BNE150725 Stage 8B Set out and Asson.mxp		Project No. BNE150725	Revision 0



Consulting Engineer's Certification:


I, Justin Holzheimer, being a certified/registered engineer and duly authorised representative of RMA Engineers hereby:


- Certify the information in this drawing is an accurate "as constructed" representation of the works.
- Accept responsibility for the "as constructed" information contained in this drawing.
- Acknowledge the "as constructed" information contained in the drawing may be relied on by Council and others.

Certification for Stage 8B by.....
on 31/01/2022 for RMA Engineers
RPEQ: 16948

REGISTERED SURVEYOR'S CERTIFICATION

DTS Group QLD Pty Ltd hereby certify that the vertical and horizontal locations and dimensions shown on this plan are a true and correct record and were located by survey.

 *[Signature]*
Registered Surveyor (sig.)
Reg. Surveyor No. 3115 Date: 31/01/2022

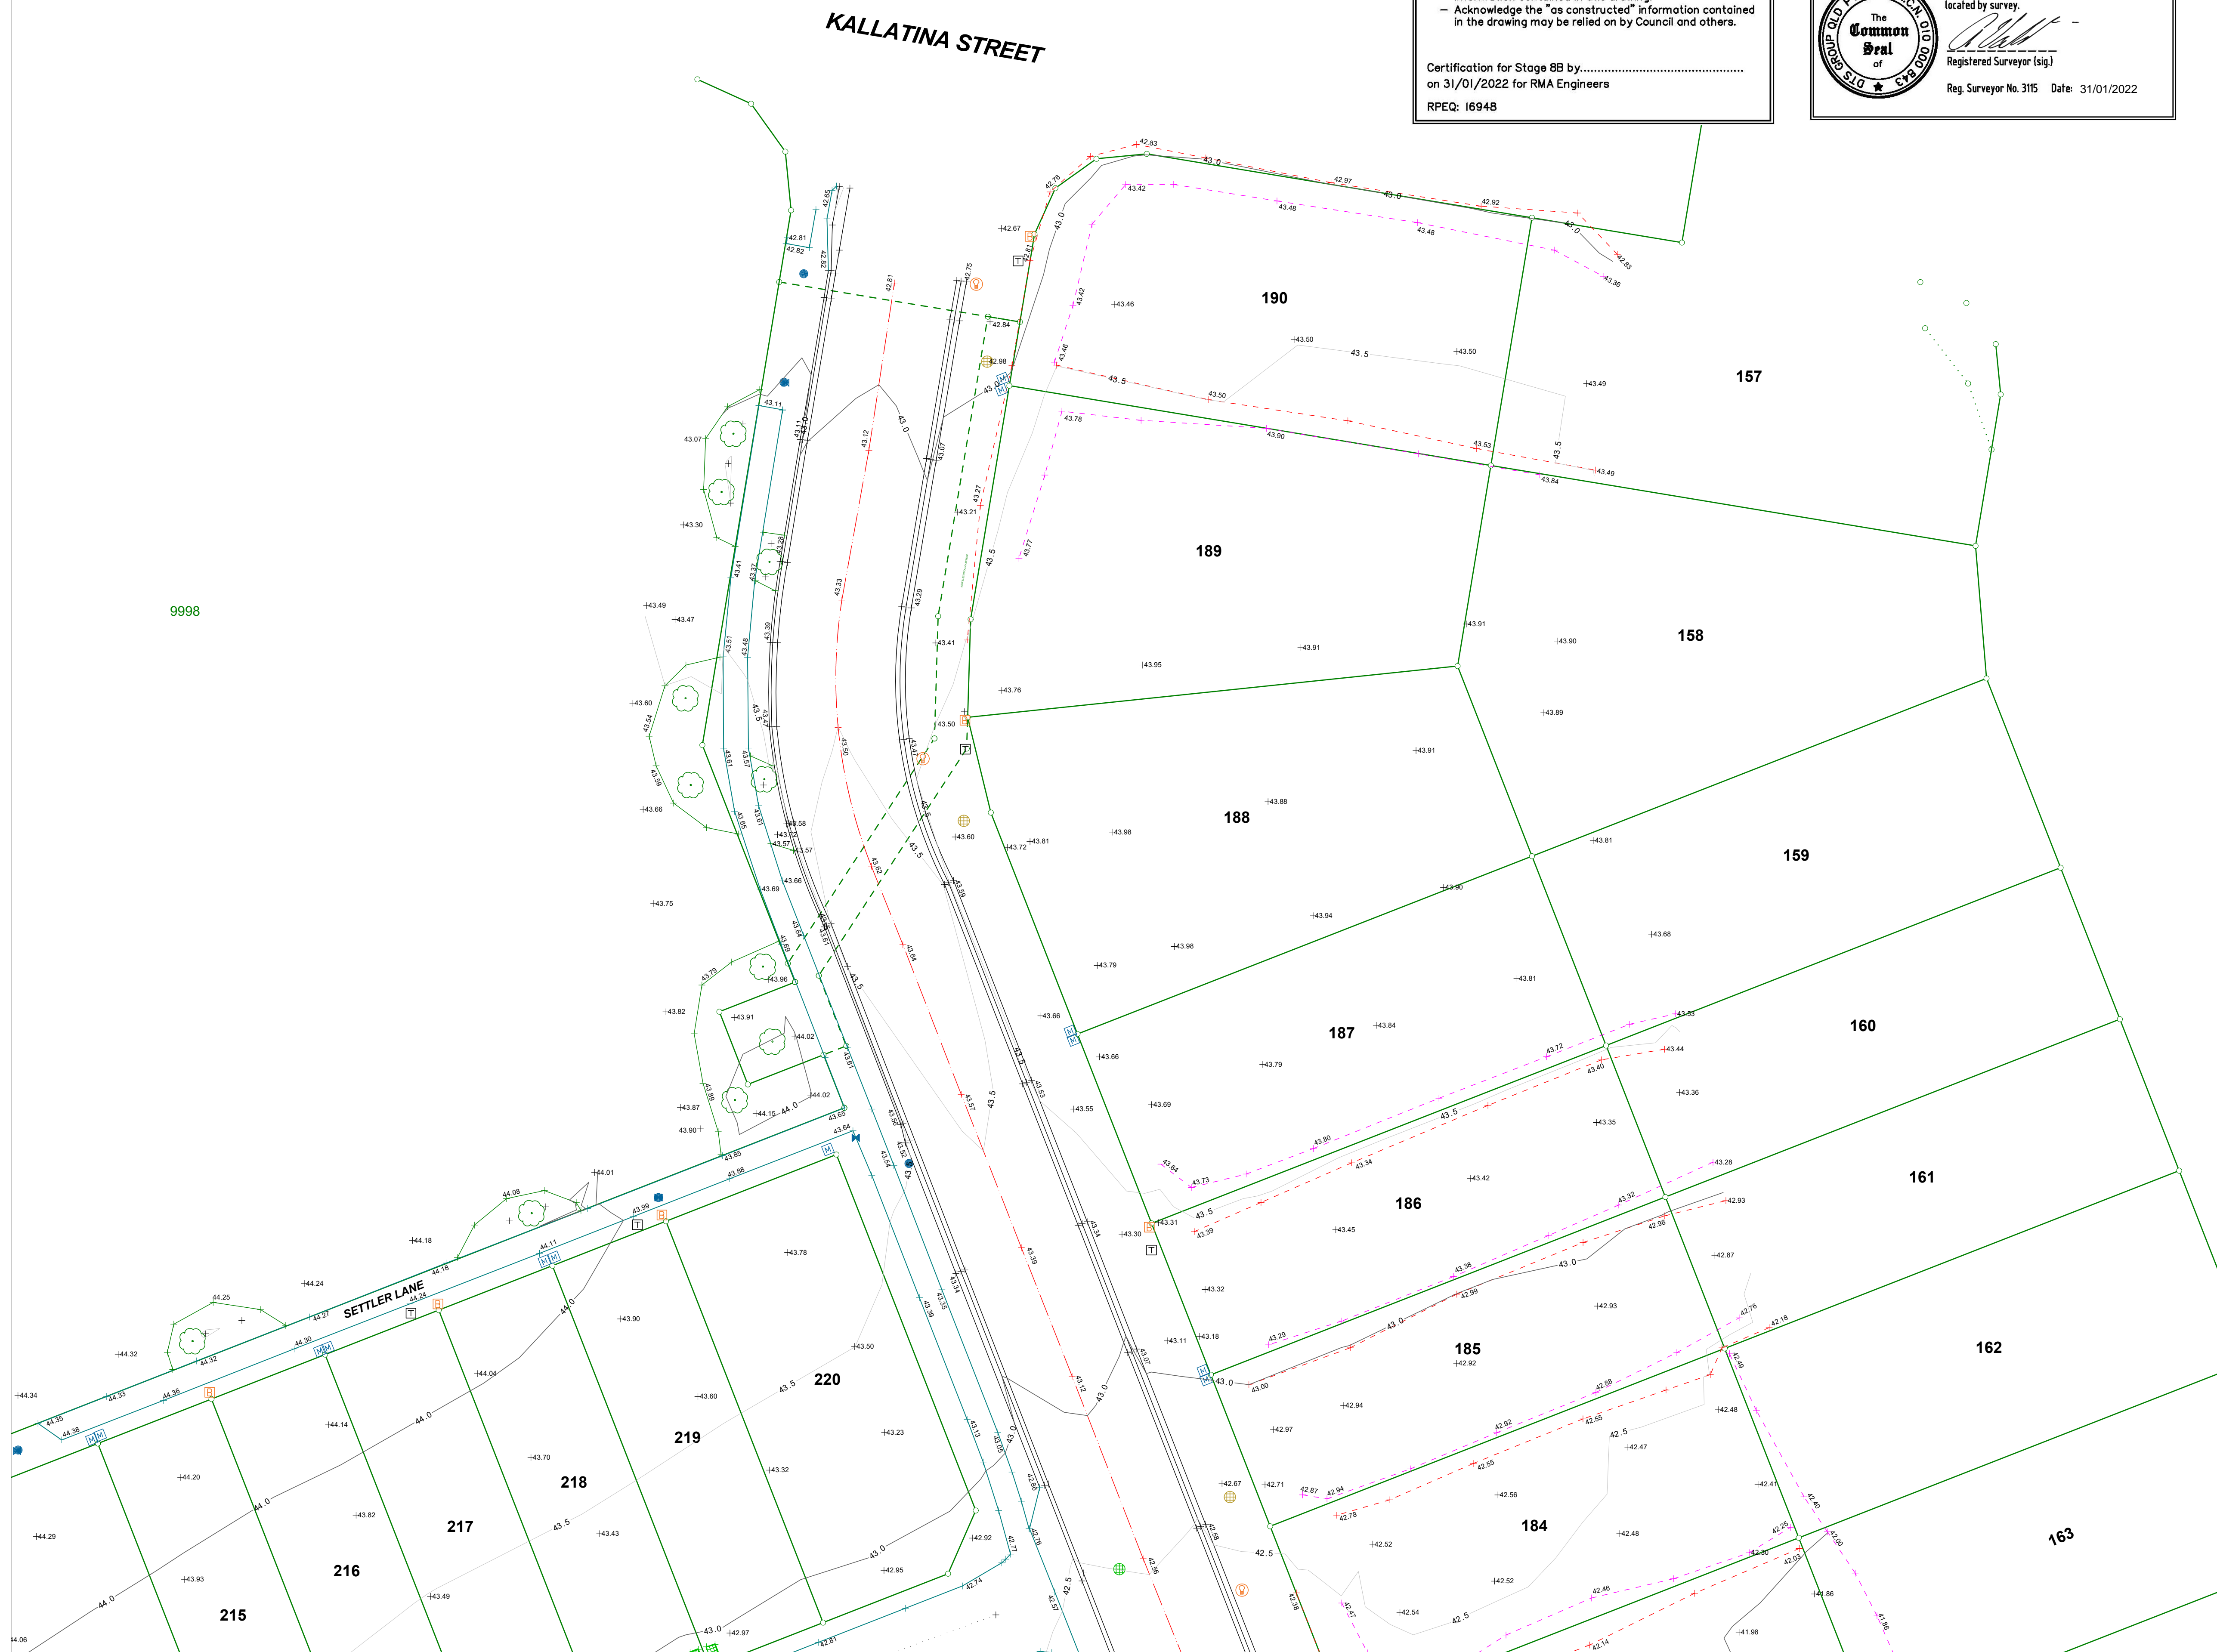

SYMBOLS

TREE CODES

FR Fruit Tree
NAT Native Tree
OR Ornamental Tree
PA Palm
PN Pine Tree
SH Shrub

TREE LEGEND

Type of Tree
Diameter
Spread of Canopy 3.0m

VT-PA0203

ABBREVIATIONS


TOG Top of Gutter
FL Floor Level
RR Roof Ridge
IL Invert Level
SL Surface Level
Ø Diameter
RET Retaining Wall

SURVEY LEGEND

Edge of Bitumen	Bottom of Bank
Retaining Wall	Crown of Road
Top of Bank	Change of Grade
Fence	Edge of Vegetation
Guard Rail	Overhead Elect
Overhead Comms	Overhead Unknown

SUBSURFACE UTILITY LEGEND (Quality Level C demonstrated below)


Comms	Electricity
Optic Fibre	Elect HV
Telstra	Elect LV
Fire Services	Petroleum
Gas	Recycled Water
Gas Low Press	Unknown
Gas High Press	Water
Drainage	Irrigation
Sewer	Rising Main

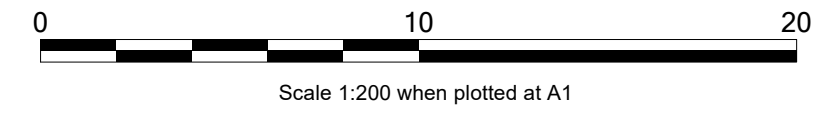

 **dts** urban planning, surveying & development

PO Box 3128 West End QLD 4101
Ph: 07 3118 0000
brisbane@dtsqld.com.au

Mackay
Ph: 1300 378 763
mackay@dtsqld.com.au

 **ELECTROSCAN**
UTILITY LOCATION, MAPPING AND PROTECTION

07 3118 0000
electroscanqld.com.au

PO Box 3128, West End 4101
Level 2, 22 Conkella Street, South Brisbane 4101

ELECTROSCAN IABN 27 010 000 843 | ACN 010 000 843

Revision	Description	Date
0	Original Issue	28/01/2022

Client: Dahua Pointcorp Narangba PTY LTD

As-Constructed Contour Survey
Callaghan Road, Narangba

Real Property Description
Lots 177-205, 214-220 and 1006 on SP317118
Locality: Narangba
Datum for Levels PMS2870 RL44.14m AHD

Surveyor RG	Locator -	Drawn RG	Date 28/01/2022	Drawing No. S11453-A1 Sheet 5
Scale 1:200@A1	Magnet File BNE150725 Stage 8B Set out and Asson.mpl		Project No. BNE150725	Revision 0