
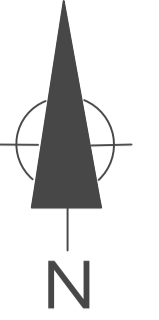


COORDINATE DATUM NOTE:
 Horizontal coordinates (E, N) supplied are MGA Zone 56, based on GDA 94.
 Horizontal datum derived from PSM52870
 E 496223.382 N 6992682.075

Levels supplied are on AHD
 Level datum derived from PSM 52870 RL 44.140m (AHD)

All distances shown on this plan are at MGA scale.
 (Combined scale factor 0.9996)

- All pipes are Class '2' Reinforced Concrete Pipes (RCP) unless noted otherwise.
- All manholes are 1050Ø with Cast Iron, Circular lids, unless noted otherwise.
- All Field Pits are 900x600 with Galvanised Grated lids unless noted otherwise.
- All bedding to pipes is Type '3' unless noted otherwise.
- Year of construction 2021.

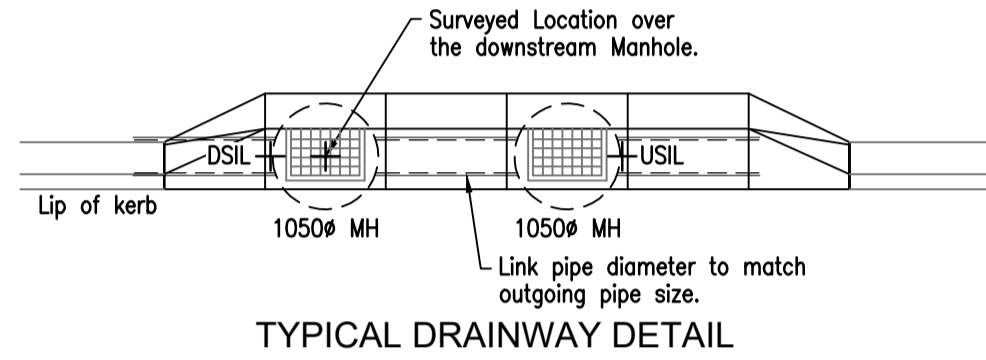

Consulting Engineer's Certification:

I, Justin Holzheimer, being a certified/registered engineer and duly authorised representative of RMA Engineers hereby:

- Certify the information in this drawing is an accurate "as constructed" representation of the works.
- Accept responsibility for the "as constructed" information contained in this drawing.
- Acknowledge the "as constructed" information contained in the drawing may be relied on by Council and others.

Certification for Stage 8B by.....
 on 28/01/2022 for RMA Engineers
 RPEQ: 16948


REGISTERED SURVEYOR'S CERTIFICATION

DTS Group QLD Pty Ltd hereby certify that the vertical and horizontal locations and dimensions shown on this plan are a true and correct record and were located by survey.

Registered Surveyor (sig.)
 Reg. Surveyor No. 3115 Date: 28/01/2022



AS CONSTRUCTED

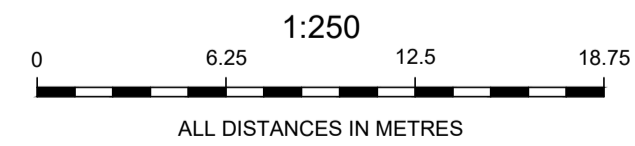

ISSUE	DATE	AS CONSTRUCTED	REVISIONS	DRAWN	CHECKED	PASSED
A	28/01/2022	AS CONSTRUCTED		AA	RC	

dts urban planning, surveying & development

Brisbane PO Box 3128, West End QLD 4101
 Ph: 07 3118 0600
 brisbane@dtsqld.com.au

Mackay PO Box 11711, Mackay Caneland QLD 4740
 Ph: 1300 278 783
 mackay@dtsqld.com.au

DRAWN	AA	28/01/2022
CHECKED	RC	28/01/2022
PASSED		
INITIALS		DATE

Moreton Bay Regional Council


Moreton Bay Regional Council

Real Property Description
 Lots 177-205, 214-220 & 1006 on SP317118
 Locality of Narangba
 Datum for Levels PM 52870 RL 44.140m AHD


Amity Narangba Stage 8B
 Burpengary & Callaghan Roads,
 Narangba

AS CONSTRUCTED DRAINAGE

SCALE	1:250 (A1)
DTS Ref:	BNE150725
DRAWING No.	A1-1501-D1
SHEET	1 of 2 SHEETS

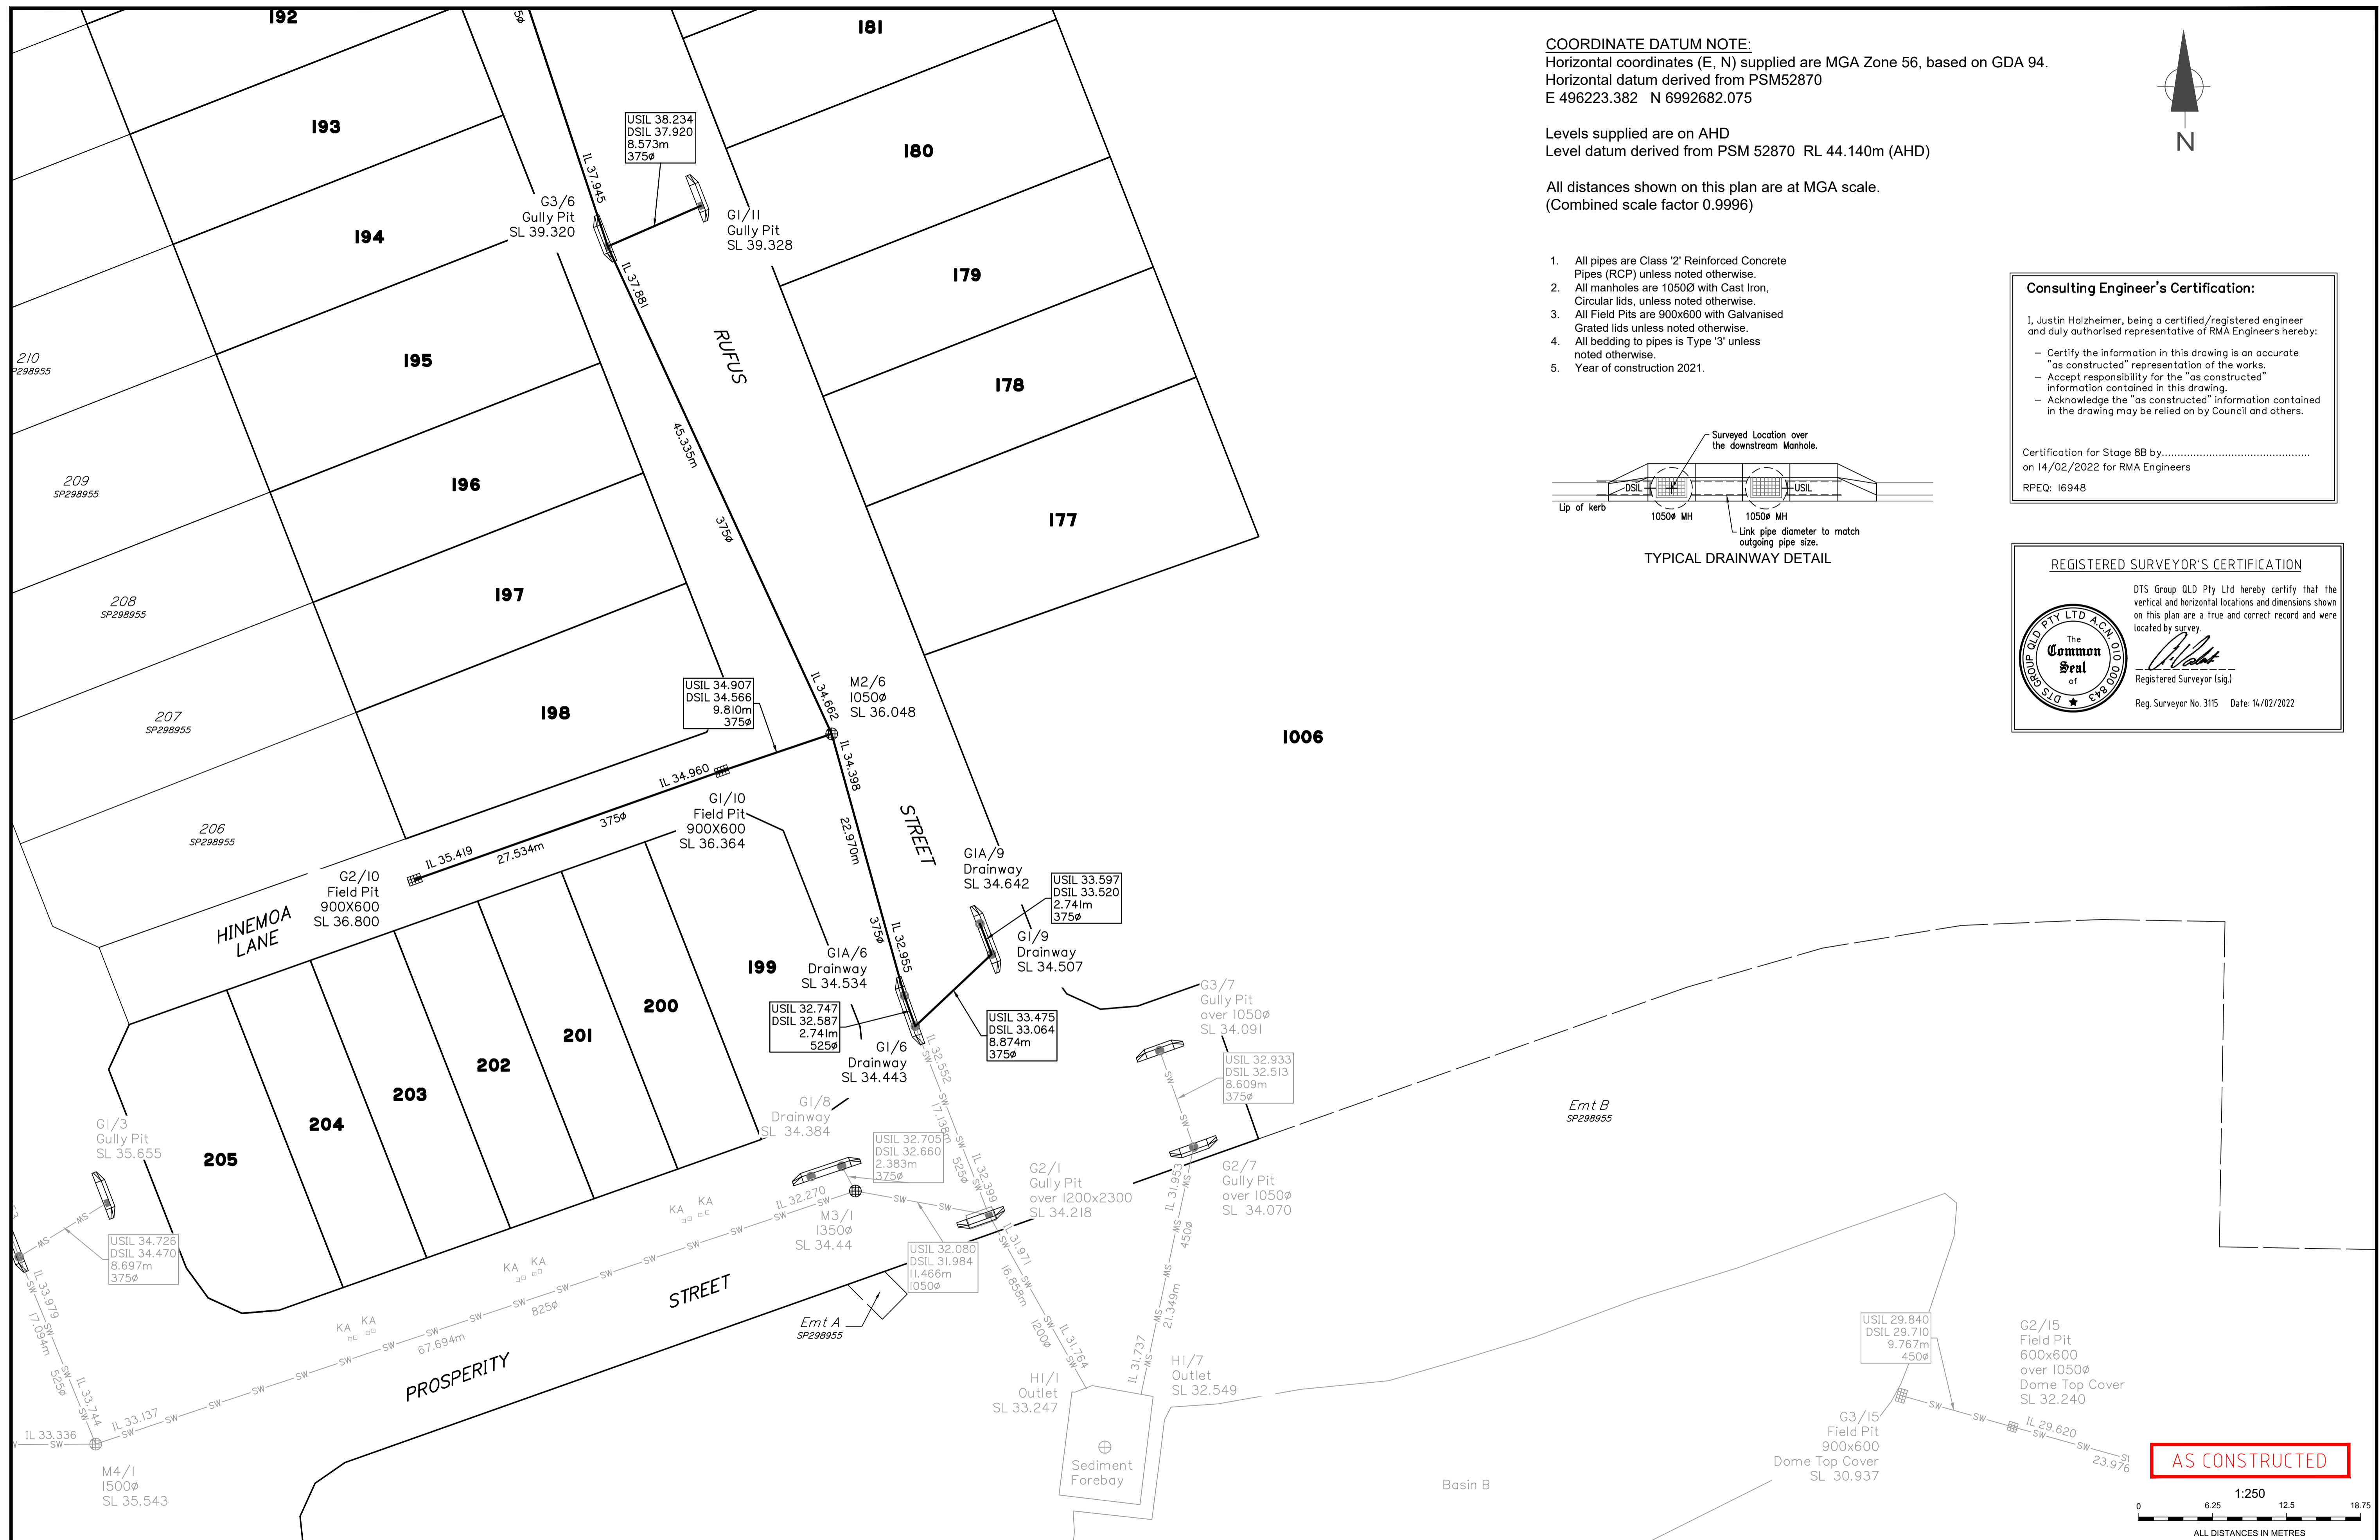


COORDINATE DATUM NOTE:
 Horizontal coordinates (E, N) supplied are MGA Zone 56, based on GDA 94.
 Horizontal datum derived from PSM52870
 E 496223.382 N 6992682.075

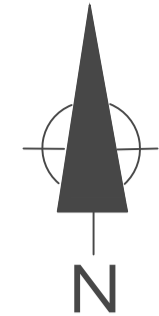

Levels supplied are on AHD
 Level datum derived from PSM 52870 RL 44.140m (AHD)

All distances shown on this plan are at MGA scale.
 (Combined scale factor 0.9996)

1. All pipes are Class '2' Reinforced Concrete Pipes (RCP) unless noted otherwise.
2. All manholes are 1050Ø with Cast Iron, Circular lids, unless noted otherwise.
3. All Field Pits are 900x600 with Galvanised Grated lids unless noted otherwise.
4. All bedding to pipes is Type '3' unless noted otherwise.
5. Year of construction 2021.

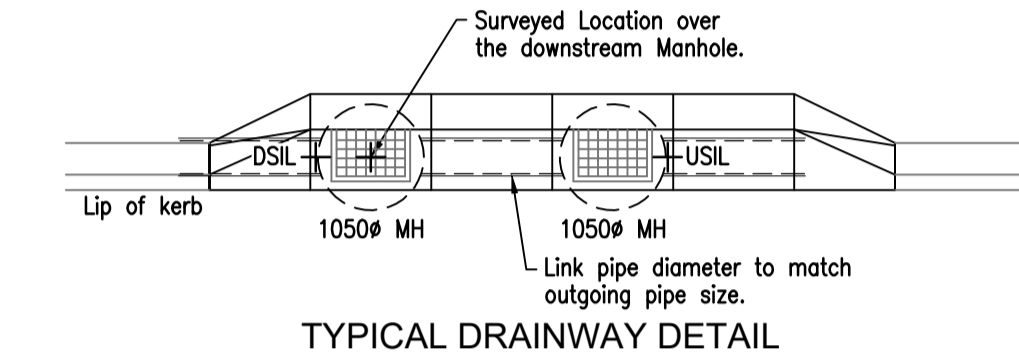

Consulting Engineer's Certification:


I, Justin Holzheimer, being a certified/registered engineer and duly authorised representative of RMA Engineers hereby:

- Certify the information in this drawing is an accurate "as constructed" representation of the works.
- Accept responsibility for the "as constructed" information contained in this drawing.
- Acknowledge the "as constructed" information contained in the drawing may be relied on by Council and others.

Certification for Stage 8B by.....
 on 14/02/2022 for RMA Engineers
 RPEQ: 16948


REGISTERED SURVEYOR'S CERTIFICATION

DTS Group QLD Pty Ltd hereby certify that the vertical and horizontal locations and dimensions shown on this plan are a true and correct record and were located by survey.

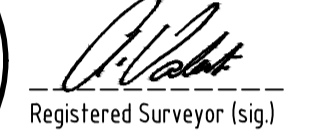

Registered Surveyor (sig.)
 Reg. Surveyor No. 3115 Date: 14/02/2022

AS CONSTRUCTED

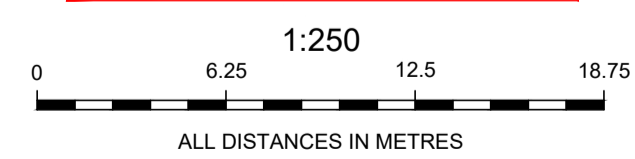

ISSUE	DATE	REVISIONS	DRAWN	CHECKED	PASSED
B	14/02/2022	INFORMATION ADDED FOR G1A/9 - G1/9	AA	RC	
A	28/01/2022	AS CONSTRUCTED	AA	RC	

dts urban planning, surveying & development

Brisbane PO Box 3128, West End QLD 4101
 Ph: 07 3118 0600
 brisbane@dtsqld.com.au

Mackay PO Box 11711, Mackay Central QLD 4740
 Ph: 1300 278 783
 mackay@dtsqld.com.au

DRAWN	AA	28/01/2022
CHECKED	RC	28/01/2022
PASSED		
INITIALS		DATE

Moreton Bay Regional Council



Moreton Bay Regional Council

Real Property Description
 Lots 177-205, 214-220 & 1006 on SP317118
 Locality of Narangba
 Datum for Levels PM 52870 RL 44.140m AHD

Amity Narangba Stage 8B
 Burpengary & Callaghan Roads,
 Narangba

AS CONSTRUCTED DRAINAGE

SCALE	1:250 (A1)
DTS Ref:	BNE150725
DRAWING No.	A1-1501-D2
SHEET	2 of 2 SHEETS